


OR
FORMATION PLUGGING RECORD

Strike out upper line
when reporting plug-
ging off formations.

Give All Information Completely
Make Required Affidavit
Mail or Deliver Report to:
Conservation Division
State Corporation Commission
800 Bitting Building
Wichita, Kansas

NORTH

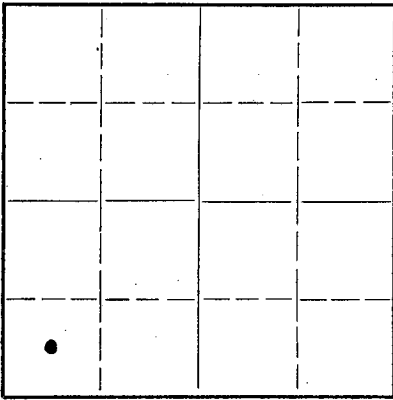

Locate well correctly on above
Section Plat

Russell County, Sec. 9 Twp. 11 S. Rge. 15 (E) W (W)
Location as "NE 1/4 NW 1/4 SW 1/4" or footage from lines C. SW 1/4 of SW 1/4
Lease Owner THE LIGGETT OIL COMPANY
Lease Name CHRISLER Well No. 2
Office Address TALIAFERRO BLDG. EL DORADO, KANSAS.
Character of Well (completed as Oil, Gas or Dry Hole) DRY HOLE
Date well completed November 7th 1942
Application for plugging filed December 6th 1942
Application for plugging approved December 6th 1942
Plugging commenced December 8th 1942
Plugging completed December 10th 1942
Reason for abandonment of well or producing formation Dry Hole no oil encountered.
If a producing well is abandoned, date of last production 19
Was permission obtained from the Conservation Division or its agents before plugging was com-
menced? Yes

Name of Conservation Agent who supervised plugging of this well C. T. Alexander.
Producing formation Depth to top Bottom Total Depth of Well 3444 Feet
Show depth and thickness of all water, oil and gas formations.


OIL, GAS OR WATER RECORDS

CASING RECORD

Formation	Content	From	To	Size	Put In	Pulled Out
				5 1/2" Csg.	3372'	2750'
				10" Csg.	190'	None.

Describe in detail the manner in which the well was plugged, indicating where the mud fluid was placed and the method or methods used in introducing it into the hold. If cement or other plugs were used, state the character of same and depth placed, from feet to feet for each plug set.
Cement from 3444 to 3400, Mud from 3400 to 3353, Wood plug set at 3353, Mud from 3353 to 190 feet, cement from 190 to 175 feet, mud and rock from 175 feet to 18 feet, Cement from 18 feet to 8 feet or bottom of cellar, Cellar with mud and dirt to top of surface.

PLUGGING
FILE SEC 9 T 11 R 15 E
BOOK PAGE 58 LINE 12

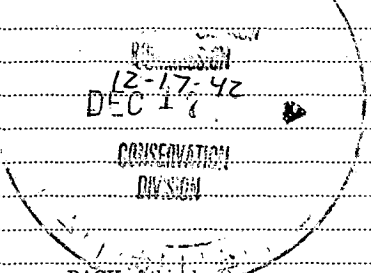

(If additional description is necessary, use BACK of this sheet)
Correspondence regarding this well should be addressed to C. Ernest Liggett, Paradise, Kansas.
Address

STATE OF Kansas, COUNTY OF Russell, ss.
C. Ernest Liggett (employee of owner or owner or operator) of the above-described well, being first duly sworn on oath, says: That I have knowledge of the facts, statements, and matters herein contained and the log of the above-described well as filed and that the same are true and correct. So help me God.

(Signature) C. Ernest Liggett
Paradise, Kansas. (Address)

Sworn to before me this Sixteenth day of December, 1942
March 18, 1945
Notary Public.

