

API NUMBER 15-167-01704-0000

LEASE NAME Chrisler B

WELL NUMBER #1

2310 Ft. from S Section Line

4290 Ft. from E Section Line

SEC. 9 TWP. 11 RGE. 15 (X) or (W)

COUNTY Russell

Date Well Completed 6/22/49

Plugging Commenced 12/19/89

Plugging Completed 12/27/89

TYPE OR PRINT  
 NOTICE: Fill out completely  
 and return to Cons. Div.  
 office within 30 days.

LEASE OPERATOR BP Exploration

ADDRESS 9401 SW Fwy, Houston, TX 77074

PHONE # (713) 272-5000 OPERATORS LICENSE NO. 06854

Character of Well Oil

(Oil, Gas, D&A, SWD, Input, Water Supply Well)

The plugging proposal was approved on December 18, 1989 (date)

by Dennis Hamelt (KCC District Agent's Name)

Is ACO-1 filed? Yes If not, Is well log attached? \_\_\_\_\_

Producing Formation L-KC Depth to Top 3076 Bottom 3427 T.D. 3457

Show depth and thickness of all water, oil and gas formations.

PBTD 3361

OIL, GAS OR WATER RECORDS

CASING RECORD

Formation	Content	From	To	Size	Put In	Pulled out
L-KC	Oil (3076-3427)	0	145	13 3/8"	115'	6'
Arbuckle	Oil (3427-NDF)	0	3414	5 1/2"	3414	6'

Describe in detail the manner in which the well was plugged, indicating where the mud fluid was placed and the method or methods used in introducing it into the hole. If cement or other plugs were used, state the character of same and depth placed, from    feet to    feet each set.  
POOH w/ 118 jts 2 7/8" tbg. Tbg parted w/ top @ 3177' There are 7 jts or 180' remaining in hole. Set EZSV @ 3000'. Pumped 100 sx cement & 300#'s hulls below @ 500 PSI. Dumped 25 sx cmt on top. Shot 4 holes @ 900'. Spotted 10 sx gel to 900' Circ 75 sx cmt to surface. Tied onto 5 1/2" & pumped 50 sx dn annulus thru perfs @ 900' Perf'd @ 150' & circ. 125 sx thru 13 3/8 X 5 1/2" annul

(If additional description is necessary, use BACK of this form.)  
 CMT: 65/35 Poz w/8% gel & 2% CaCl

Name of Plugging Contractor Halliburton License No. 5287

Address 1100 E. 8th, Hays, Kansas

RECEIVED  
 STATE CORPORATION COMMISSION

NAME OF PARTY RESPONSIBLE FOR PLUGGING FEES: BP Exploration

1-17-90  
 JAN 17 1990


STATE OF Texas COUNTY OF Harris, ss.

Scott Marshall (Employee of Operator) or Operator of

above-described well, being first duly sworn on oath, says: That I have knowledge of the facts, statements, and matters herein contained and the log of the above-described well as filed that the same are true and correct, so help me God.

(Signature) Scott Marshall

(Address) 9401 SW Fwy, Houston, TX 77074

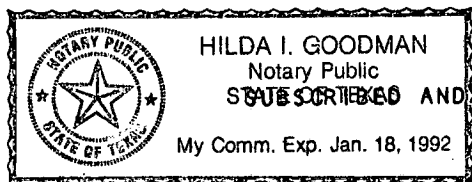

HILDA I. GOODMAN  
 Notary Public  
 STATE OF TEXAS  
 My Comm. Exp. Jan. 18, 1992

SWORN TO before me this 15th day of January, 19 90

Hilda I. Goodman  
 Notary Public

My Commission Expires: 1-18-92

Russell County

CHRISLER B#1

15-167-01704-0000

FAIRPORT

Sec 9 T11S R15W  
NE-NW-SW

SPUD: 5/49  
TA'O: 5-86  
TD: 3457'

PBTD: 33611'

22-141 50 SHEETS  
22-142 100 SHEETS  
22-144 200 SHEETS



1000'

2000'

3000'

4000'

13 3/8" @ 145', 48 ppf H40

130 SX CMT  
1 1/2" HOLE

Repair Csg leak @ 500'  
50 SX POEMIX (1954)

Repair Csg leak w/  
100 SX CMT (1982)  
Leak @ 755' (Dakota)

RECEIVED  
STATE CORPORATION COMMISSION

NOV 13 1989

CONSERVATION DIVISION  
Wichita, Kansas

ARBUCKLE  
OPEN HOLE

Plug @  
3390' w/  
15X CMT

L-KC  
5 1/2" @ 3414', 14 ppf H40  
125 SX CMT  
7 7/8" HOLE

L-KC Perfs: 3106-3117', 3120-24', 3134-38',  
3164-67', 3175-78', 3242-46',  
3265-77', 3294-97'