


WELL PLUGGING RECORD

Give All Information Completely
Make Required Affidavit
Mail or Deliver Report to:
Conservation Division
State Corporation Commission
800 Bittling Building
Wichita, Kansas

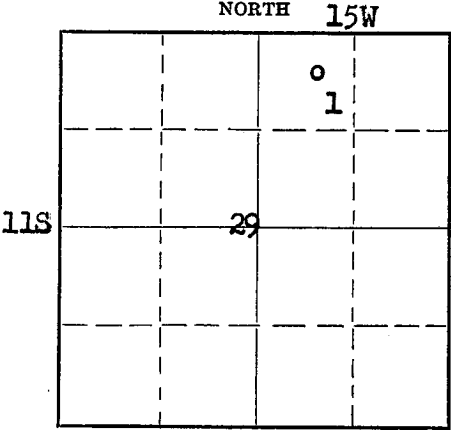

Russell County, Sec. 29 Twp. 11S Rge. 15 (E) W (W)

Location as "NE/CNW $\frac{1}{4}$ SW $\frac{1}{4}$ " or footage from lines NE $\frac{1}{4}$ NW $\frac{1}{4}$ NE $\frac{1}{4}$
Lease Owner Stanolind Oil and Gas Company
Lease Name F. Booth "B" Well No. 1
Office Address Box 591, Tulsa, Oklahoma
Character of Well (completed as Oil, Gas or Dry Hole) Oil
Date well completed March 17, 19.29
Application for plugging filed October 20, 19.50
Application for plugging approved November 16, 19.50
Plugging commenced December 18, 19.50
Plugging completed December 29, 19.50
Reason for abandonment of well or producing formation Depleted producer

Locate well correctly on above Section Plat

If a producing well is abandoned, date of last production October 5, 19.49
Was permission obtained from the Conservation Division or its agents before plugging was commenced? Yes

Name of Conservation Agent who supervised plugging of this well Mr. Eldon Petty
Producing formation Lansing & Sooy Depth to top 3120 Bottom 3261 Total Depth of Well 3265 Feet
Show depth and thickness of all water, oil and gas formations.

OIL, GAS OR WATER RECORDS

CASING RECORD

Formation	Content	From	To	Size	Put In	Pulled Out
Lansing	Oil	3120	3151	5" OD	133'	—
Sooy	Oil	3253	3261	6-5/8" OD	3107'	2489'
				8-5/8" OD	2654'	508'

Describe in detail the manner in which the well was plugged, indicating where the mud fluid was placed and the method or methods used in introducing it into the hole. If cement or other plugs were used, state the character of same and depth placed, from _____ feet to _____ feet for each plug set.

Crushed rock and 4 sax cement 3261'-3110'
Dumped mud 3110'-250'
Crushed rock 250'-240'
Cement (25 sax) 240'-220'
Dumped mud 220'-30'
Crushed rock 30'-20'
Cement (15 sax) 20'-Surface


RECEIVED
STATE CORPORATION COMMISSION
JAN 24 1951
CONSERVATION DIVISION
Wichita, Kansas

(If additional description is necessary, use BACK of this sheet)

Correspondence regarding this well should be addressed to Mr. C. B. Snyder
Address Box 35
Gorham, Kansas

STATE OF Kansas, COUNTY OF Russell, ss.
G. B. Snyder (employee of owner) or (owner or operator) of the above-described well,
being first duly sworn on oath, says: That I have knowledge of the facts, statements, and matters herein contained and the log of the above-described well as filed and that the same are true and correct. So help me God.

(Signature) *G. B. Snyder*
Box 35, Gorham, Kansas
(Address)

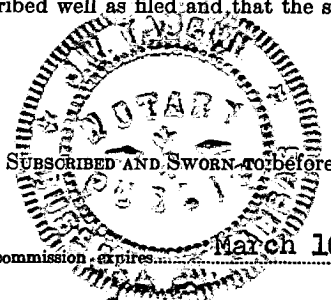

SUBSCRIBED AND SWORN to before me this 22nd day of January, 1951.
My commission expires March 10, 1952

[Signature]
Notary Public.