


WELL PLUGGING RECORD

Give All Information Completely  
Make Required Affidavit  
Mail or Deliver Report to:  
Conservation Division  
State Corporation Commission  
800 Bitting Building  
Wichita, Kansas

Russell County. Sec. 29 Twp. 11S Rge. 15 ~~W~~ W (W)

Location as "NE/CNW $\frac{1}{4}$ SW $\frac{1}{4}$ " or footage from lines SE NW NE  
Lease Owner Stanolind Oil and Gas Company  
Lease Name Frank H. Booth "B" Well No. 2  
Office Address Box 591, Tulsa, Oklahoma  
Character of Well (completed as Oil, Gas or Dry Hole) Salt Water Disposal Well  
Date well completed July 16 19 39  
Application for plugging filed August 31 19 51  
Application for plugging approved September 4 19 51  
Plugging commenced October 1 19 51  
Plugging completed October 5 19 51  
Reason for abandonment of well or producing formation No longer needed as  
input well.

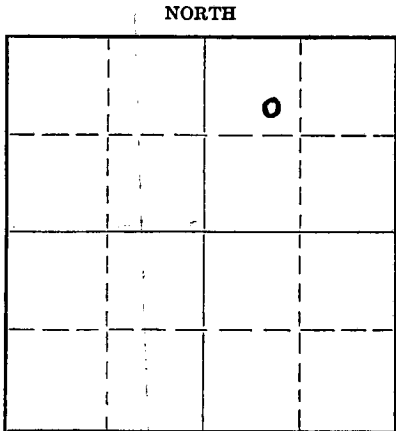

Locate well correctly on above Section Plat

If a producing well is abandoned, date of last production Not applicable 19  
Was permission obtained from the Conservation Division or its agents before plugging was commenced?

Name of Conservation Agent who supervised plugging of this well Eldon Petty  
Producing formation Depth to top Bottom Total Depth of Well 3212 Feet  
Show depth and thickness of all water, oil and gas formations.

OIL, GAS OR WATER RECORDS

CASING RECORD

Formation	Content	From	To	Size	Put In	Pulled Out
				16"	40	0
				7"	3016	627'

Describe in detail the manner in which the well was plugged, indicating where the mud fluid was placed and the method or methods used in introducing it into the hole. If cement or other plugs were used, state the character of same and depth placed, from feet to feet for each plug set.  
TD 3212' crushed rock to 3000', dumped 5 sax cement to 2940, Heavy mud to 250', crushed rock & 25 sax cement, Heavy mud to 20', 15 sax cement to cap well.

RECEIVED  
STATE CORPORATION COMMISSION  
OCT 24 1951 10-24-51  
CONSERVATION DIVISION  
Wichita, Kansas

NOTE: Well record was submitted with original application to convert well from oil to salt water disposal.


(If additional description is necessary, use BACK of this sheet)

Correspondence regarding this well should be addressed to C. B. Snyder  
Address Box 35, Gorham, Kansas

STATE OF Kansas, COUNTY OF Russell, ss.  
C. B. Snyder (employee of owner) or (owner or operator) of the above-described well,  
being first duly sworn on oath, says: That I have knowledge of the facts, statements, and matters herein contained and the log of the above-described well as filed and that the same are true and correct. So help me God.

(Signature) *C. B. Snyder* Field Sup't.  
Box 35, Gorham, Kansas  
(Address)

SUBSCRIBED AND SWORN to before me this 18th day of October, 19 51  
My commission expires May 18, 1955

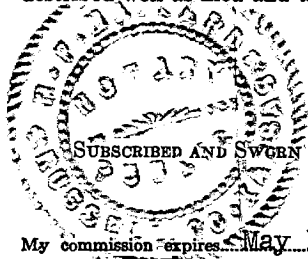

PLUGGING  
FILE SEC 29 T 11 R 15W  
BOOK PAGE 107 LINE 2