

15-167-03880-00-00

WELL PLUGGING RECORD

STATE OF KANSAS- STATE CORPORATION COMMISSION


Give All Information Completely Make Required Affidavit Mail or Deliver Report to: Conservation Division State Corporation Commission 800 Bitting Building Wichita, Kansas

OR

FORMATION PLUGGING RECORD

Strike out upper line when reporting plugging off formations.

NORTH

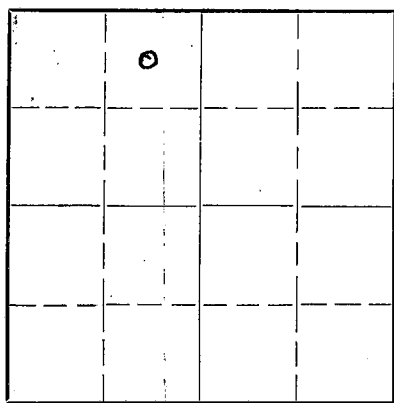

Locate well correctly on above Section Plat

Russell County. Sec. 20 Twp. 13 Rge. (E) 11 (W) Location as "NE 1/4 NW 1/4 SW 1/4" or footage from lines C NE NW Lease Owner Ingling & Parker Lease Name Marshall Well No. 1 Office Address 708 Fourth National Bank Bldg., Wichita 2, Kansas Character of Well (completed as Oil, Gas or Dry Hole) dry hole Date well completed October 7 1943 Application for plugging filed October 8 1943 Application for plugging approved October 8 1943 Plugging commenced October 8 1943 Plugging completed October 8 1943 Reason for abandonment of well or producing formation dry If a producing well is abandoned, date of last production none 19 Was permission obtained from the Conservation Division or its agents before plugging was commenced? yes

Name of Conservation Agent who supervised plugging of this well B. T. Alexander Producing formation Depth to top Bottom Total Depth of Well 3447 Feet Show depth and thickness of all water, oil and gas formations.


OIL, GAS OR WATER RECORDS

CASING RECORD

Table with 7 columns: Formation, Content, From, To, Size, Put In, Pulled Out. Row 1: 8 5/8, 325, none

Describe in detail the manner in which the well was plugged, indicating where the mud fluid was placed and the method or methods used in introducing it into the hold. If cement or other plugs were used, state the character of same and depth placed, from feet to feet for each plug set.

Well had 325' of 8 5/8" O.D. surface pipe. The hole was circulated for two hours with heavy mud. A wood plug was forced to bottom of 8 5/8" pipe with drill pipe. 15 sacks cement were mixed and put on top of plug through drill pipe. The hole was mudded to 25 feet within top. Six sacks cement were mixed and poured on top of plug through 2" pipe. The surface pipe was cut off 8 inches below surface and plugging finished October 8, 1943 at 6 p.m.

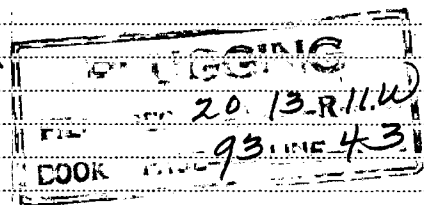

(If additional description is necessary, use BACK of this sheet) Correspondence regarding this well should be addressed to Ingling & Parker Address 708 Fourth National Bank Bldg., Wichita 2, Kansas

STATE OF Kansas, COUNTY OF Sedgwick, ss. D. T. Ingling (employee of owner) or (owner or operator) of the above-described well, being first duly sworn on oath, says: That I have knowledge of the facts, statements, and matters herein contained and the log of the above-described well as filed and that the same are true and correct. So help me God. Ingling & Parker

(Signature) [Signature]

708-4th Nat'l Bk. Bldg., Wichita, Kans. (Address)

SUBSCRIBED AND SWORN to before me this 12 day of October, 1943

[Signature] Notary Public.



WELL LOG MARSHALL NO. 1

| | |
|------------------------------------|-------------------------|
| Lease Owner: Ingling & Parker | Section 20-13-11W |
| Contractors: Ingling & Parker | Location: C NE NW |
| Total depth: 3447' | County: Russell, Kansas |
| Date Commenced: September 15, 1943 | Elevation: 1745' |
| Date Completed: October 8, 1943 | Production: Dry |
| Casing: 325' of 8 5/8" O.D. | |

Figures below indicate bottom of formation

| | | | |
|-------------------------|------|---------------------|-----------|
| Clay. sand & rock | 95 | Shale & shells | 2405 |
| Shale & shells | 140 | Shale & lime shells | 2565 |
| Redrock, shale & shells | 365 | Lime & shale | 2600 |
| Red rock | 630 | Lime - iron | 2630 |
| Anhydrite | 665 | Lime | 2825 |
| Shale & shells | 1090 | Sandy lime & shale | 2900 |
| Lime shells & shale | 1350 | Lime & shale | 2925 |
| Lime & shale | 1590 | Hard lime | 2940 |
| Shale & shells | 1630 | Lime | 3025 |
| Sandy lime & shale | 1925 | Hard lime | 3084 |
| Shale & lime | 1995 | Lime | 3125 |
| Shale & shells | 2045 | Lime & shale | 3232 |
| Sandy lime & shale | 2095 | Shale & lime | 3311 |
| Shale & broken lime | 2165 | Lime | 3390 |
| Shale & lime | 2245 | Lime, shale & sand | 3408 |
| Shale | 2325 | Lime | 3447 T.D. |

We hereby certify that this is a true and correct log of the above-mentioned well.


INGLING & PARKER

J.T. Ingling

STATE OF KANSAS)
 COUNTY OF SEDGWICK) ss

Subscribed and sworn to before me, A Notary Public in above said county and State, this 13 day of October, 1943.

My commission expires:

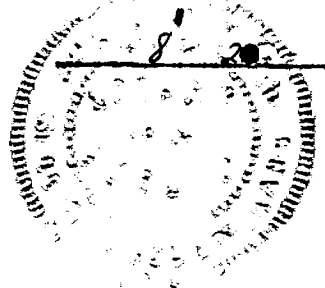

10-14-1943 *Julia M. Head*
 Notary Public

20 13 11W
 93 43