

STATE OF KANSAS
STATE CORPORATION COMMISSION


Give All Information Completely
Make Required Affidavit
Mail or Deliver Report to:
Conservation Division
State Corporation Commission
212 No. Market
Wichita, Kansas

15-167-20441-00-00 Form CP-4
WELL PLUGGING RECORD

Russell County, Sec. 18 Twp. 13S Rge. XXXX 12(W)

Location as "NE/CNW/SE/SW" or footage from lines SE SE NW
Lease Owner Pickrell Drilling Company
Lease Name Sidey Ranches "A" Well No. 1
Office Address 705 Fourth National Bank Building, Wichita, Kansas
Character of Well (completed as Oil, Gas or Dry Hole) Dry Hole
Date well completed August 31 1970
Application for plugging filed August 31 1970
Application for plugging approved August 31 1970
Plugging commenced August 31 1970
Plugging completed August 31 1970
Reason for abandonment of well or producing formation Dry Hole

NORTH

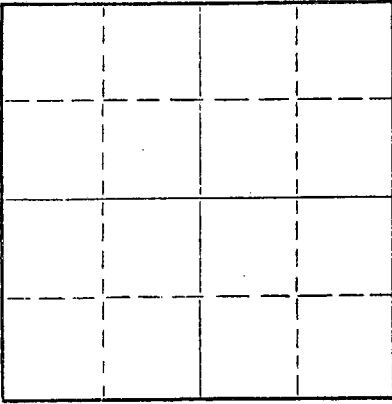

Locate well correctly on above Section Plat

If a producing well is abandoned, date of last production 19
Was permission obtained from the Conservation Division or its agents before plugging was commenced? Yes

Name of Conservation Agent who supervised plugging of this well Donald Truan
Producing formation _____ Depth to top _____ Bottom _____ Total Depth of Well 3490 Feet
Show depth and thickness of all water, oil and gas formations.

OIL, GAS OR WATER RECORDS

CASING RECORD

FORMATION	CONTENT	FROM	TO	SIZE	PUT IN	PULLED OUT
				8-5/8"	217'	None

Describe in detail the manner in which the well was plugged, indicating where the mud fluid was placed and the method or methods used in introducing it into the hole. If cement or other plugs were used, state the character of same and depth placed, from _____ feet to _____ feet for each plug set.

Plug No. 1 set @ 480' w/40 sacks cement, Plug No. 2 set @ 200' w/35 sacks, Plug No. 3 set @ 46' w/20 sacks cement.

RECEIVED
STATE CORPORATION COMMISSION
SEP 9 1970
CONSERVATION DIVISION
Wichita, Kansas

09-09-1970

(If additional description is necessary, use BACK of this sheet)

Name of Plugging Contractor Pickrell Drilling Company
Address 705 Fourth National Bank Building, Wichita, Kansas 67202


STATE OF Kansas, COUNTY OF Sedgwick, ss.
_____, (employee of owner) or (owner or operator) of the above-described well, being first duly sworn on oath, says: That I have knowledge of the facts, statements, and matters herein contained and the log of the above-described well as filed and that the same are true and correct. So help me God.

(Signature) Saloth Robinson

(Address)

SUBSCRIBED AND SWORN to before me this 4th day of September 1970

My commission expires May 1973

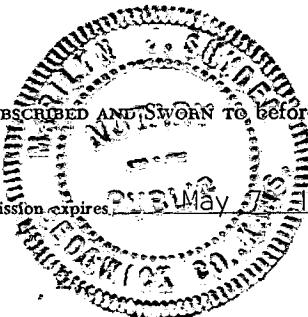

Marilyn J. Snyder
Marilyn J. Snyder Notary Public.

ROTARY DRILLING LOG

15-167-20441-00-00

COMPANY: Pickrell Drilling Company
705 Fourth National Bank Building
Wichita, Kansas 67202

Rotary Drilling Commenced 8/23/70

Rotary Drilling Completed 8/31/70

LOCATION: Sidey Ranches "A" No. 1, SE SE NW Section 18-13S-12W
Russell County, Kansas

CONTRACTOR: **PICKRELL DRILLING COMPANY**
Wichita, Kansas

CASING RECORD: Run 10 Jts. 8-5/8" surface casing set @ 217' KB. Cemented with
140 Sacks Cement. Completed 5:00 P.M. Circulated.

No oil string run. D & A, Plugged 11:45 A.M. August 31, 1970.

LOG

(Figures indicate bottom of formation -- measurements from top of rotary bushing.)

125	Post Rock - Shale	<u>C.F.S.</u>
217	Shale & Shells	3045
660	Shale & Sand Streaks	3112
789	Red Bed	3163
826	Anhydrite	3375
1350	Shale - Shells	3472
2255	Lime & Shale	3490
2480	Shale & Lime	
2560	Lime & Shale	
2730	Shale & Lime	
3490	Lime, RTD	

	<u>S.L.M.</u>
Board	3067.26
Strap	<u>3066.26</u>
	1.00 Short

<u>Slope Tests</u>
2000
2500
3000

09-09-1970
RECEIVED
STATE CORPORATION COMMISSION
SEP 9 1970
CONSERVATION DIVISION
Wichita, Kansas

The undersigned, Dale M. Robinson, Attorney-in-Fact for PICKRELL DRILLING COMPANY, hereby certifies in behalf of said Company, that the above is a true and correct log of the formation encountered in drilling the above well as reflected by the Daily Drilling Reports.

PICKRELL DRILLING COMPANY

By Dale M. Robinson
Attorney-in-Fact

STATE OF KANSAS }
COUNTY OF SEDGWICK } ss.:

On this 4th day of September, 19 70, before me the undersigned, a Notary Public, in and for the County and State aforesaid, personally appeared _____, to me known to be the identical person who subscribed the name of PICKRELL DRILLING COMPANY to the foregoing instrument as its Attorney-in-Fact and acknowledged to me that he executed the same as his free and voluntary act and deed, and as the free and voluntary act and deed of such company, for the uses and purposes therein set forth.

Given under my hand and seal of office the day and year last above written.

My commission expires: May 7, 1973

[Signature]
Notary Public