


Give All Information Completely
Make Required Affidavit
Mail or Deliver Report to:
Conservation Division
State Corporation Commission
800 Bitting Building
Wichita, Kansas

Ellis County. Sec. 7 Twp. 11 Rge. 16 ~~XX~~ (W)
Location as "NE/CNW&SW" or footage from lines. NE NE SE
Lease Owner Braden Drilling Co. et al
Lease Name Fees Well No. 1
Office Address 802 Union National Bank Bldg.
Character of Well (completed as Oil, Gas or Dry Hole) dry
Date well completed 8-24-53 19
Application for plugging filed 8-24-53 19
Application for plugging approved 8-25-53 19
Plugging commenced 8-25-53 19
Plugging completed 8-25-53 19
Reason for abandonment of well or producing formation dry

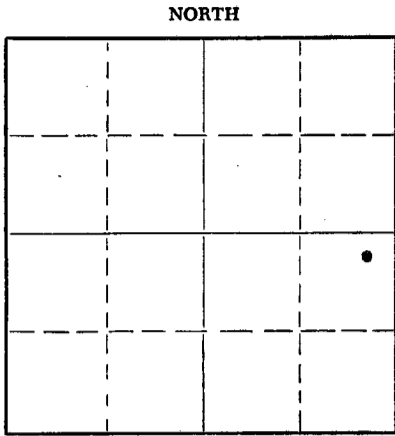

Locate well correctly on above
Section Plat

If a producing well is abandoned, date of last production _____ 19____
Was permission obtained from the Conservation Division or its agents before plugging was commenced? yes

Name of Conservation Agent who supervised plugging of this well Mr. Eldon Petty, Box 326, Hays, Kansas
Producing formation _____ Depth to top _____ Bottom _____ Total Depth of Well 3471 Feet
Show depth and thickness of all water, oil and gas formations.

OIL, GAS OR WATER RECORDS

CASING RECORD

FORMATION	CONTENT	FROM	TO	SIZE	PUT IN	PULLED OUT
				8-5/8	195'	none

Describe in detail the manner in which the well was plugged, indicating where the mud fluid was placed and the method or methods used in introducing it into the hole. If cement or other plugs were used, state the character of same and depth placed, from _____ feet to _____ feet for each plug set.

Filled hole with heavy mud from total depth to 180' where bottom plug was set. Twenty sacks were dumped on top of bottom plug. Continued to fill hole with heavy mud to 40' where top plug was set. Ten sacks cement dumped on top of top plug. Cellar filled with top soil.

RECEIVED
STATE CORPORATION COMMISSION

AUG 28 1953

RCWD
08-28-53

CONSERVATION DIVISION
WICHITA, KANSAS

(If additional description is necessary, use BACK of this sheet)

Name of Plugging Contractor Braden Drilling Co.
Address 802 Union National Bank Bldg., Wichita, Kansas

STATE OF Kansas, COUNTY OF Sedgwick, ss.
Louis E. Potucek (employee of owner) or (owner or operator) of the above-described well, being first duly sworn on oath, says: That I have knowledge of the facts, statements, and matters herein contained and the log of the above-described well as filed and that the same are true and correct. So help me God.

(Signature) Louis E. Potucek
802 Union National Bank Bldg.
(Address)

SUBSCRIBED AND SWORN to before me this 27th day of August, 1953
My commission expires April 29, 1957
Norma Risher
Notary Public.

24-2675-5 2-52-20M



PLUGGING
FILE SEC-7-T-11-R-16W
BOOK PAGE 124 LINE 30

FEES #1

Operator: Van Zandt & Braden Drilling Co.

7-11-16

NE NE SE

Contractor: Braden Drilling Company

Ellis County, Kansas

Test Commenced: 8-13-53

Elev. 1877 D.F.

Test Completed: 8-23-53

Casing Record: Set 195' of 8-5/8" casing, cemented with 145 sacks cement, 200# c.c.

Shale	60
Shale & shells	425
Sand	590
Shale & red bed	850
Red bed	1073
Anhydrite	1107
Shale & shells	1580
Shale & salt	1610
Shale & lime	1700
Broken lime	1895
Lime	2100
Broken lime	2260
Lime & shale	2495
Shale	2710
Shale & lime	2865
Lime	2995
Lime & shale	3035
Lime	3385
Conglomerate	3470
Lime	3471 T.D. R.B.

STATE OF KANSAS,) (SS:-
SEDGWICK COUNTY,)

I hereby certify that the above information is true and correct as revealed by the records of the Braden Drilling Company.

ONSEI... DIVISION
Wichita, Kansas

Norma Riley

Subscribed and sworn to before me this 25th day of August, 1953.

David F. Paterek
Notary Public



My commission expires: Feb. 13, 1954.

PLUGGING
FILE SEC 7-T-11-R-16W
BOOK PAGE 124 LINE 30