

15-051-01370-0000

STATE OF KANSAS
STATE CORPORATION COMMISSION


Give All Information Completely
Make Required Affidavit
Mail or Deliver Report to:
Conservation Division
State Corporation Commission
211 No. Broadway
Wichita, Kansas

WELL PLUGGING RECORD

ELLIS County, Sec. 7 Twp. 11 Rge. 16 (E) W (W)

Location as "NE/CNW%SW%" or footage from lines NE NE NE
Lease Owner PETROLEUM INC.
Lease Name ROMINE Well No. 1
Office Address Route 2, Great Bend, Kansas
Character of Well (completed as Oil, Gas or Dry Hole) Dry Hole
Date well completed January 7 1957
Application for plugging filed January 7 1957
Application for plugging approved January 7 1957
Plugging commenced January 7 1957
Plugging completed January 7 1957
Reason for abandonment of well or producing formation No Producing Zones

NORTH

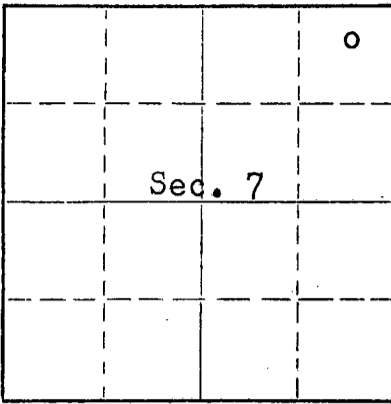

Locate well correctly on above Section Plat

If a producing well is abandoned, date of last production None 19
Was permission obtained from the Conservation Division or its agents before plugging was commenced? Yes

Name of Conservation Agent who supervised plugging of this well Eldon Petty, Box 326, Hays, Kansas
Producing formation ----- Depth to top --- Bottom --- Total Depth of Well 3540' Feet
Show depth and thickness of all water, oil and gas formations.

OIL, GAS OR WATER RECORDS

CASING RECORD

FORMATION	CONTENT	FROM	TO	SIZE	PUT IN	PULLED OUT
				8 5/8" OD	312'	None

Describe in detail the manner in which the well was plugged, indicating where the mud fluid was placed and the method or methods used in introducing it into the hole. If cement or other plugs were used, state the character of same and depth placed, from _____ feet to _____ feet for each plug set.

Mud up with heavy mud to 290', pushed down 1/4 sack hulls to 290' followed by wooden plug. Placed 20 sacks cement through drill pipe on to Plug. Mud up to 40' and place 1/4 sack hulls at 40' followed by wooden plug and 10 sacks cement to base of well cellar.

(If additional description is necessary, use BACK of this sheet)

Name of Plugging Contractor Garvey Drilling Co.
Address Route 2, Great Bend, Kansas

STATE OF KANSAS, COUNTY OF BARTON, ss.
BON SEARLE (employee of owner) or (owner) of the above-described well, being first duly sworn on oath, says: That I have knowledge of the facts, statements, and matters herein contained and the log of the above-described well as filed and that the same are true and correct. So help me God.

(Signature) *Bon Searle*
Route 2, Great Bend, Kansas (Address)

SUBSCRIBED AND SWORN TO before me this 10th day of January, 1957

My commission expires July 11, 1960

John J. Brown Notary Public.

RECEIVED STATE CORPORATION COMMISSION

JAN 11 1957
01-11-57
CONSERVATION DIVISION
Wichita, Kansas

PLUGGING
FILE SEC 7 T 11 R 16 W
BOOK PAGE 132 LI E 21

WELL LOG 15-051-0370-0000

COMPANY PETROLEUM, INCORPORATED

SEC. 7 T. 11S R. 16W

FARM ROMINE NO. 1


LOC. NE, NE, NE

TOTAL DEPTH 3540'

COUNTY Ellis Co., Kansas

COMM. December 26, 1956 COMP. January 7, 1957

CONTRACTOR GARVEY DRILLING COMPANY

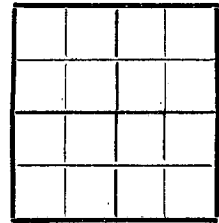

CASING 8 5/8" @ 312' W/175 sax.

ELEVATION 1888' DF

PRODUCTION D & A

FIGURES INDICATE BOTTOM OF FORMATIONS

50	Surface clay
615	Shale & shells
775	Sand
980	Shale & red bed
1080	Red bed
1115	Anhydrite
1290	Shale & shells
1690	Shale & streaks of Pyrite.
1775	Shale & shells
2160	Lime & shale
2295	Lime
2948	Lime & shale
3040	Lime
3106	Lime & shale
3358	Lime
3415	Conglomerate, cherty lime & shale
3436	Conglomerate & cherty lime
3455	Lime & shale
3495	Lime & chert
3540	Arbuckle lime.

State of KANSAS
County of BARTON

PLUGGING
 FILE SEC 7 T. 11 R. 16W
 BOOK PAGE 132 LINE 21

RECEIVED
 STATE COMMISSION
 JAN 11 1957
 CONSERVATION DIVISION

I, Verne A. Morris of Garvey Drilling Co.

upon oath state that the above and foregoing is a true and correct copy of the log of the #1 Romine well

Verne A. Morris

Subscribed and sworn to before me this 9th day of January 19 57

My Commission Expires: July 11, 1960

Led B. Brown
NOTARY PUBLIC