

15-051-21222-0000

FORM CP-4

STATE OF KANSAS
STATE CORPORATION COMMISSION
CONSERVATION DIVISION
P. O. BOX 17027
WICHITA, KANSAS 67217

WELL PLUGGING RECORD

Ellis County, Sec. 7 Twp. 11 Rge. 16W (E) (W)

Location as "NE/CNW&SW" or footage from lines. SE SE SE

Lease Owner Robert Price

Lease Name Finch Well No. #1

Office Address Box 45442/Tulsa, Oklahoma 74145

Character of Well (completed as Oil, Gas or Dry Hole) Dry Hole

Date well completed 3-25-77 19

Application for plugging filed 3-25-77 19

Application for plugging approved 3-25-77 19


Plugging commenced 3-25-77 19

Plugging completed 3-25-77 19

Reason for abandonment of well or producing formation Dry hole

If a producing well is abandoned, date of last production 19

Was permission obtained from the Conservation Division or its agents before plugging was commenced? Yes

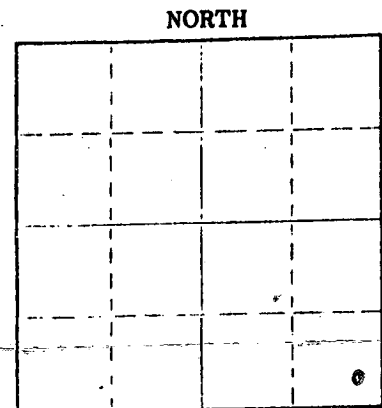

Locate well correctly on above Section Plat

Name of Conservation Agent who supervised plugging of this well Leo Massey

Producing formation -- Depth to top -- Bottom -- Total Depth of Well 3427' Feet

Show depth and thickness of all water, oil and gas formations.

OIL, GAS OR WATER RECORDS

CASING RECORD

FORMATION	CONTENT	FROM	TO	SIZE	PUT IN	PULLED OUT
				8 5/8"	262'	None

Describe in detail the manner in which the well was plugged, indicating where the mud fluid was placed and the method or methods used in introducing it into the hole. If cement or other plugs were used, state the character of same and depth placed, from feet to feet for each plug set.

Plugged with 50 sacks 50/50 Pozmix 25% gel @ 500', 25 sacks 50/50 Pozmix 2% gel @ 240', solid bridge and 10 sacks 50/50 Pozmix 2% gel @ 40'.
Job complete @ 9 A.M. by Sun Oilwell Cementing.

RECEIVED
STATE CORPORATION COMMISSION
MAY 13 1977
PCW
05-13-77

CONSERVATION DIVISION
Wichita, Kansas

(If additional description is necessary, use BACK of this sheet)

Name of Plugging Contractor Allen Drilling Company

Address Box 1389/Great Bend, Ks 67530

STATE OF Kansas COUNTY OF Barton ss.

Earl Allen (employee of owner) or (owner or operator) of the above-described well, being first duly sworn on oath, says: That I have knowledge of the facts, statements, and matters herein contained and the log of the above-described well as filed and that the same are true and correct. So help me God.

(Signature) X Earl Allen

P.O. Box 1389/Great Bend, KS 67530

(Address)

SUBSCRIBED AND SWORN TO before me this 28th day of March, 1977

My commission expires 11-25-79 Lavelta M. Murnahan Notary Public.

