


15-051-03730-0000

WELL PLUGGING RECORD

Give All Information Completely
Make Required Affidavit
Mail or Deliver Report to:
Conservation Division
State Corporation Commission
800 Bittling Building
Wichita, Kansas

Ellis County, Sec. 9 Twp. 11 Rge. 16 (E) W (W)
Location as "NE/CNW $\frac{1}{4}$ SW $\frac{1}{4}$ " or footage from lines NW/CN NE/4 NW/4
Lease Owner Honaker Drilling Co., Inc.
Lease Name Craig Well No. 1
Office Address 2008 Lakin, Great Bend, Kansas
Character of Well (completed as Oil, Gas or Dry Hole) Dry Hole
Date well completed July 28 19 51
Application for plugging filed July 28 19 51
Application for plugging approved July 28 19 51
Plugging commenced July 28 19 51
Plugging completed July 28 19 51
Reason for abandonment of well or producing formation

NORTH

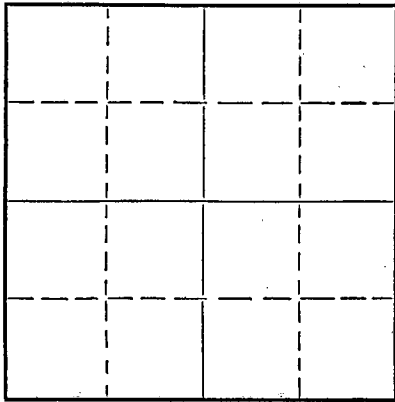

Locate well correctly on above Section Plat

If a producing well is abandoned, date of last production 19
Was permission obtained from the Conservation Division or its agents before plugging was commenced? Yes

Name of Conservation Agent who supervised plugging of this well Elden Petty
Producing formation Depth to top Bottom Total Depth of Well 3560 Feet
Show depth and thickness of all water, oil and gas formations.

OIL, GAS OR WATER RECORDS

CASING RECORD

Formation	Content	From	To	Size	Put In	Pulled Out
				8 5/8	223	none

Describe in detail the manner in which the well was plugged, indicating where the mud fluid was placed and the method or methods used in introducing it into the hole. If cement or other plugs were used, state the character of same and depth placed, from feet to feet for each plug set.


Hole filled with heavy mud
First Plug set at 210 ft. with $\frac{1}{2}$ sack hulls and 15 sacks hand mixed cement on top.
Second Plug set at 40 ft with $\frac{1}{2}$ sack hulls and 10 sacks hand mixed cement on top

RECEIVED
STATE CORPORATION COMMISSION
AUG 1 X 1951
RCW
08-01-51
CONSERVATION DIVISION
Wichita, Kansas

(If additional description is necessary, use BACK of this sheet)
Correspondence regarding this well should be addressed to Honaker Drilling Co., Inc.
Address 2008 Lakin, Great Bend, Kansas

STATE OF Kansas, COUNTY OF Barton, ss.
Earnest Fisher (employee of owner) or (owner or operator) of the above-described well,
being first duly sworn on oath, says: That I have knowledge of the facts, statements, and matters herein contained and the log of the above-described well as filed and that the same are true and correct. So help me God.
(Signature) Earnest Fisher

SUBSCRIBED AND SWORN to before me this 31 day of July, 19 51
Kenneth L. Fisher
Notary Public.

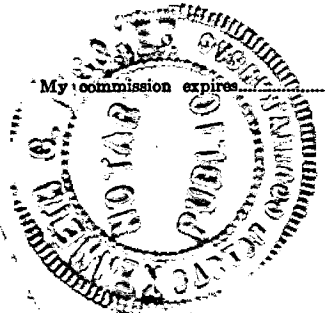

PLUGGING
FILE SEC 9-T-11-R-16
BOOK PAGE 99 LINE 24

15-051-03730-0000

Operator: Honaker Drilling Co., Inc.
Contractor: Honaker Drilling Co., Inc.
Lease: Craig #1 NW NE NW 9-11S-16W
Ellis County, Kansas

Commenced: 7-16-51
Completed: 7-28-51

Clay	0	65
Clay, Shale, Sand	65	220
Run joints 8 5/8" Surface Casing. Set at 220 ft. - cemented with 125 Sacks cement		
Sand - Shale	220	610
Shale-Lime	610	815
Shale	815	905
Sand	905	930
Red Bed-Shale	930	1015
Red Bed-Shale	1015	1065
Anhydrite	1065	1105
Shale-Shells	1105	1150
Shale-Lime	1150	1485
Lime-Shale	1485	1722
Lime	1722	1820
Lime	1820	2000
Lime-Shale	2000	2215
Lime	2215	2390
Lime	2390	2495
Lime-Shale	2495	2615
Shale-Lime	2615	2750
Shale-Lime	2750	2880
Lime-Shale	2880	2925
Lime-Shale	2925	3045
Lime-Shale	3045	3080
Lime-Shale	3080	3155
Lime	3155	3203
Lime	3203	3305
Lime	3305	3355
Lime	3355	3460
Lime	3460	3500
Lime	3500	3560 T.D.

C
O
P
Y

The above is correct to the best of my knowledge

HONAKER DRILLING COMPANY, INC.

By Joe J. Honaker
President

Subscribed and sworn before me this 28th day of July 1951

My Commission Expires: June 25, 1955

NOTARY PUBLIC
COMMISSION
CONSERVATION DIVISION
WARRANT, Kansas

Notary Public
Barton County, Kansas

PLUGGING
FILE SEC 9-T-11-16W
BOOK PAGE 99 LINE 24