


15-051-21748-0000

STATE OF KANSAS
STATE CORPORATION COMMISSION

Give All Information Completely
Make Required Affidavit
Mail or Deliver Report to:
Conservation Division
State Corporation Commission
212 North Market, Insurance Bldg.
Wichita, Kansas

WELL PLUGGING RECORD

NORTH

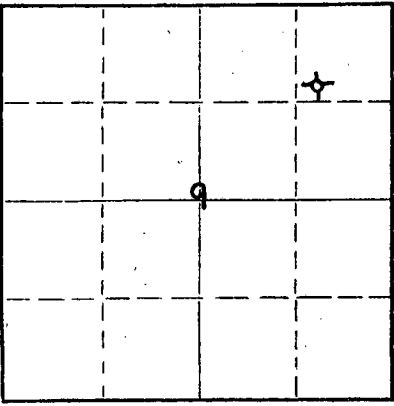

Locate well correctly on above
Section Plat

Ellis County, Sec. 9 Twp. 11S Rge. 16W (X) (W)
Location as "NE/CNW%SW%" or footage from lines SW NE NE
Lease Owner John O. Farmer, Inc.
Lease Name Craig Well No. #1
Office Address P.O. Box 352, Russell, KS 67665
Character of Well (completed as Oil, Gas or Dry Hole) Dry Hole
Date well completed September 11, 19 79
Application for plugging filed Yes 19
Application for plugging approved 19
Plugging commenced 19
Plugging completed 6:00 A.M., September 11, 19 79
Reason for abandonment of well or producing formation

If a producing well is abandoned, date of last production 19
Was permission obtained from the Conservation Division or its agents before plugging was commenced? Yes

Name of Conservation Agent who supervised plugging of this well Marion Schmidt
Producing formation Depth to top Bottom Total Depth of Well Feet
Show depth and thickness of all water, oil and gas formations.

OIL, GAS OR WATER RECORDS

CASING RECORD

FORMATION	CONTENT	FROM	TO	SIZE	PUT IN	PULLED OUT

Describe in detail the manner in which the well was plugged, indicating where the mud fluid was placed and the method or methods used in introducing it into the hole. If cement or other plugs were used, state the character of same and depth placed, from feet to feet for each plug set.

Plug #1 720' w/70 sx. cement
Plug #2 200' w/20 sx. cement
Plug #3 40' w/10 sx. cement

RECEIVED
STATE CORPORATION COMMISSION

SEP 20 1979 09-20-79

CONSERVATION DIVISION
Wichita, Kansas


(If additional description is necessary, use BACK of this sheet)
Name of Plugging Contractor John O. Farmer, Inc.
Address P.O. Box 352, Russell, KS 67665

STATE OF Kansas, COUNTY OF Russell, ss.
John O. Farmer (employee of owner) or (owner or operator) of the above-described

well, being first duly sworn on oath, says: That I have knowledge of the facts, statements, and matters herein contained and the log of the above-described well as filed and that the same are true and correct. So help me God.

(Signature) John O. Farmer
P.O. Box 352, Russell, KS 67665
(Address)

Subscribed AND SWORN to before me this 18th day of September, 19 79

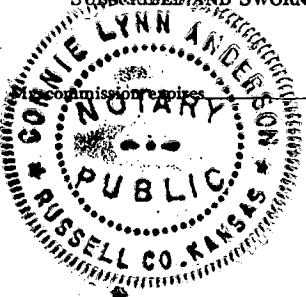

March 29, 1983
Connie Lynn Anderson
Notary Public.

KANSAS DRILLERS LOG

S. 9 T. 11S R. 16W ^{XX}_W

Loc. SW NE NE

County Ellis

API No. 15 — 051 — 21,748 - 0000
 County Number

Operator John O. Farmer, Inc.

Address P.O. Box 352, Russell, KS 67665


Well No. #1 Lease Name Craig

Footage Location
990 feet from (N) XX line 990 feet from (E) XW line

Principal Contractor John O. Farmer, Inc. Geologist Sam L. Farmer

Spud Date 8-31-79 Total Depth _____ P.B.T.D. _____

Date Completed 9-11-79 Oil Purchaser _____

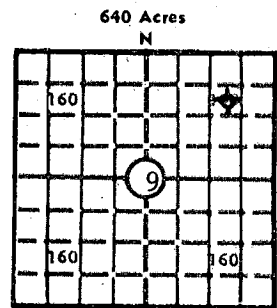

Locate well correctly
 Elev.: Gr. 1891'
 DF 1894' KB 1896'

CASING RECORD

Report of all strings set — surface, intermediate, production, etc.

Purpose of string	Size hole drilled	Size casing set (in O.D.)	Weight lbs/ft.	Setting depth	Type cement	Sacks	Type and percent additives
Surface	12-1/4"	8-5/8"	28	208'	Common	165	

LINER RECORD

PERFORATION RECORD

Top, ft.	Bottom, ft.	Sacks cement	Shots per ft.	Size & type	Depth interval

TUBING RECORD

Size	Setting depth	Packer set at

ACID, FRACTURE, SHOT, CEMENT SQUEEZE RECORD

Amount and kind of material used	Depth interval treated

RECEIVED
 STATE CORPORATION COMMISSION
 SEP 20 1979

INITIAL PRODUCTION

CONSERVATION DIVISION
 Wichita, Kansas

Date of first production	Producing method (flowing, pumping, gas lift, etc.)				
RATE OF PRODUCTION PER 24 HOURS	Oil	Gas	Water	Gas-oil ratio	
	bbls.	MCF	bbls.	CFPB	
Disposition of gas (vented, used on lease or sold)			Producing interval (s)		

INSTRUCTIONS: As provided in KCC Rule 82-2-125, within 90 days after completion of a well, one completed copy of this Drillers Log shall be transmitted to the State Geological Survey of Kansas, 4150 Monroe Street, Wichita, Kansas 67209. Copies of this form are available from the Conservation Division, State Corporation Commission, 3830 So. Meridian (P.O. Box 17027), Wichita, Kansas 66217. Phone AC 316-522-2206. If confidential custody is desired, please note Rule 82-2-125. Drillers Logs will be on open file in the Oil and Gas Division, State Geological Survey of Kansas, Lawrence, Kansas 66044.

Operator John O. Farmer, Inc.		DESIGNATE TYPE OF COMP.: OIL, GAS, DRY HOLE, SWDW, ETC.:
Well No. #1	Lease Name Craig	Dry Hole
S <u>9</u> T <u>11S</u> R <u>16W</u> ^{XX} W		


WELL LOG

Show all important zones of porosity and contents thereof; cored intervals, and all drill-stem tests, including depth interval tested, cushion used, time tool open, flowing and shut-in pressures, and recoveries.

SHOW GEOLOGICAL MARKERS, LOGS RUN, OR OTHER DESCRIPTIVE INFORMATION.

FORMATION DESCRIPTION, CONTENTS, ETC.	TOP	BOTTOM	NAME	DEPTH
Clay	-0-	50		Sample Tops
Blue Shale	50	208		
Shale & Sand	208	650	Anhydrite	1065 (+831)
Sand	650	725	Topeka	2817 (-921)
Red Bed	725	1065	Heebner	3046 (-1150)
Anhydrite	1065	1104	Toronto	3078 (-1182)
Shale & Lime	1104	2785	Lansing	3099 (-1203)
Lime & Shale	2785	2975	B/KC	3346 (-1450)
Shale & Lime	2975	3070	Conglomerate	3410 (-1514)
Lime & Shale	3070	3210	Simpson	3478 (-1582)
Lime	3210	3500	T.D.	3500 (-1604)
<p>DST #1 3118-58 Tool open 30-45-60-60 - fair to strong blow Rec: 180' gas 120' gassy oil cut mud; 37% oil, 15% water, 20% mud, 28% gas FP: 51-61 BHP: 848-940</p> <p>DST #2 3200-3345 Tool open 30-30 - weak blow, 20 min. Rec: 20' mud FP: 71-71 BHP: 725</p>				

USE ADDITIONAL SHEETS, IF NECESSARY, TO COMPLETE WELL RECORD.

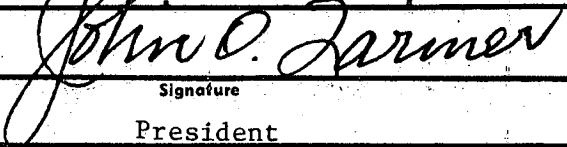Date Received	
	Signature
	President
	Title
	September 18, 1979
	Date