


15-051-01007-0000

WELL PLUGGING RECORD

Give All Information Completely
Make Required Affidavit
Mail or Deliver Report to:
Conservation Division
State Corporation Commission
211 No. Broadway
Wichita, Kansas

NORTH

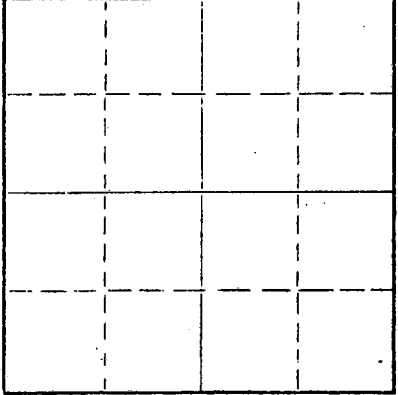

Locate well correctly on above
Section Plat

Ellis County, Sec. 9 Twp. 11S Rge. (E) 16 (W)
Location as "NE/CNW%SW%" or footage from lines CW/2 E/2 SW/4
Lease Owner Chief Drilling Co., Inc.
Lease Name CRAIG Well No. 1
Office Address Box 797 - Great Bend, Kansas
Character of Well (completed as Oil, Gas or Dry Hole) Dry Hole
Date well completed 12/2 1963
Application for plugging filed 12/2 1963
Application for plugging approved 12/2 1963
Plugging commenced 12/2 1963
Plugging completed 12/2 1963
Reason for abandonment of well or producing formation Dry Hole

If a producing well is abandoned, date of last production 19
Was permission obtained from the Conservation Division or its agents before plugging was commenced? Yes

Name of Conservation Agent who supervised plugging of this well Eldon Petty - Hays, Kansas
Producing formation Depth to top Bottom Total Depth of Well 3465 Feet
Show depth and thickness of all water, oil and gas formations.

OIL, GAS OR WATER RECORDS

CASING RECORD

| FORMATION | CONTENT | FROM | TO | SIZE | PUT IN | PULLED OUT |
|-----------|---------|------|------|--------|--------|------------|
| | | 0 | 209' | 8-5/8" | 209' | None |
| | | | | | | |
| | | | | | | |
| | | | | | | |
| | | | | | | |
| | | | | | | |
| | | | | | | |
| | | | | | | |

Describe in detail the manner in which the well was plugged, indicating where the mud fluid was placed and the method or methods used in introducing it into the hole. If cement or other plugs were used, state the character of same and depth placed, from feet to feet for each plug set.

Wooden plug set @ 350'
Mixed 20 sacks cement through drill pipe
Wooden plug set @ 180'
Mixed 20 sacks cement through drill pipe
1/3 sack hulls and wooden plug set @ 35'
Mixed 10 sacks cement through drill pipe

RECEIVED
STATE CORPORATION COMMISSION
DEC 4 1963
12-04-63
CONSERVATION DIVISION
Wichita, Kansas

(If additional description is necessary, use BACK of this sheet)
Name of Plugging Contractor Chief Drilling Co., Inc.
Address Box 797 - Great Bend, Kansas

STATE OF KANSAS, COUNTY OF BARTON, ss.
V. Richard Hoover, President (employee of owner) or (owner or operator) of the above-described well, being first duly sworn on oath, says: That I have knowledge of the facts, statements, and matters herein contained and the log of the above-described well as filed and that the same are true and correct. So help me God. CHIEF DRILLING CO., INC.

(Signature) V. Richard Hoover
Box 797 - Great Bend, Kansas (Address)



SUBSCRIBED AND SWORN to before me this 2nd day of December, 1963
Jan. 26, 1967. Carmen R. Cook, Notary Public.

15-051-01007-0000

WELL LOG

Chief Drilling Co., Inc.
Box 797
Great Bend, Kansas

CRAIG #1
CW/2 E/2 SW/4 Sec. 9-11S-16W
Ellis County, Kansas

Contractor: Chief Drilling Co., Inc.

Commenced: 11/23/63
Completed: 12/2/63

Casing Record: 8-5/8" @ 209' w/150 sacks Sunset Cement.

DRY & ABANDONED

RECEIVED
STATE CORPORATION COMMISSION

DEC 4 1963

CONSERVATION DIVISION
Wichita, Kansas

FORMATION TOPS

FROM TO

ELEVATION

| | | |
|-------------------------|------|------|
| Surface Sand & Gravel | 0 | 209 |
| Shale, Shells & Red Bed | 209 | 1010 |
| Anhydrite | 1010 | 1040 |
| Shale & Shells | 1040 | 1890 |
| Shale & Lime | 1890 | 2763 |
| Lime | 2763 | 3000 |
| Shale & Lime | 3000 | 3048 |
| Lime | 3048 | 3289 |
| Shale & Lime | 3289 | 3344 |
| Conglomerate | 3344 | 3420 |
| Sand & Shale | 3420 | 3460 |
| Dolomite | 3460 | 3465 |
| Total Depth | 3465 | |

1841 Gr.
1843 D.F.
1846 K.B.

FORMATION TOPS

| | Sample | Log |
|------------------|-------------|-------------|
| Anhydrite | 1010 + 836 | 1008 + 838 |
| Howard | 2741 - 895 | 2740 - 894 |
| Topeka | 2763 - 917 | 2762 - 916 |
| Heebner | 3000 - 1154 | 2998 - 1152 |
| Toronto | 3023 - 1177 | 3021 - 1175 |
| Lansing | 3048 - 1202 | 3042 - 1196 |
| Base Kansas City | 3289 - 1443 | 3288 - 1442 |
| Conglomerate | 3344 - 1498 | 3344 - 1498 |
| Simpson | 3420 - 1574 | 3419 - 1573 |
| Arbuckle | 3460 - 1614 | 3462 - 1616 |
| Total Depth | 3465 - 1619 | 3464 - 1618 |

STATE OF KANSAS, COUNTY OF BARTON) SS

I hereby certify that the above is a true and correct copy of the Driller's Log of the well drilled in the CW/2 E/2 SW/4 of Sec. 9-11S-16W, Ellis County, Kansas, to the best of my knowledge and belief.


CHIEF DRILLING CO., INC.

V. Richard Hoover
V. Richard Hoover, President

Subscribed and sworn to before me this 2nd day of December, 1963.

Carmen R. Cook
Carmen R. Cook, Notary Public

My commission expires: Jan. 26, 1967.

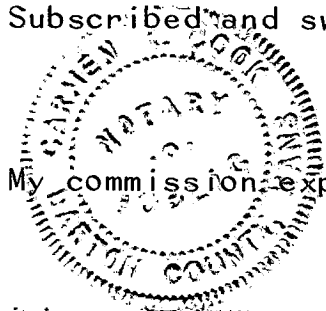

RECEIVED
STATE CORPORATION COMMISSION

DEC 4 1963

CONSERVATION DIVISION
Wichita, Kansas