

15-051-01146-0001

15-051-01164-00-00


STATE OF KANSAS  
STATE CORPORATION COMMISSION

Form CP-4

Give All Information Completely  
Make Required Affidavit  
Mail or Deliver Report to:  
Conservation Division  
State Corporation Commission  
212 No. Market  
Wichita, Kansas

### WELL PLUGGING RECORD

Ellis County. Sec. 16 Twp. 11 Rge. 16W (X) (W)  
Location as "NE/CNW/SW" or footage from lines SE SE SE  
Lease Owner White & Fry  
Lease Name Lundy Well No. 1  
Office Address 201 Mobil Bldg., Wichita, Kansas  
Character of Well (completed as Oil, Gas or Dry Hole) D&A  
Date well completed \_\_\_\_\_ 19\_\_\_\_  
Application for plugging filed \_\_\_\_\_ 19\_\_\_\_  
Application for plugging approved \_\_\_\_\_ 19\_\_\_\_  
Plugging commenced July 17, 19 61  
Plugging completed July 17, 19 61  
Reason for abandonment of well or producing formation \_\_\_\_\_

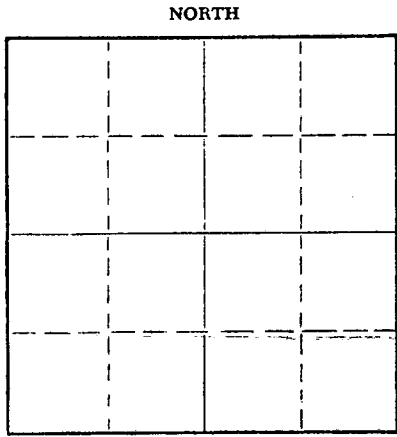

Locate well correctly on above Section Plat

If a producing well is abandoned, date of last production \_\_\_\_\_ 19\_\_\_\_  
Was permission obtained from the Conservation Division or its agents before plugging was commenced? yes

Name of Conservation Agent who supervised plugging of this well Eldon Petty  
Producing formation \_\_\_\_\_ Depth to top \_\_\_\_\_ Bottom \_\_\_\_\_ Total Depth of Well 3318 Feet  
Show depth and thickness of all water, oil and gas formations.

#### OIL, GAS OR WATER RECORDS

#### CASING RECORD

| FORMATION | CONTENT | FROM | TO | SIZE | PUT IN | PULLED OUT |
|-----------|---------|------|----|------|--------|------------|
|           |         |      |    |      |        |            |
|           |         |      |    |      |        |            |
RECEIVED  
STATE CORPORATION COMMISSION  
AUG 18 1966  
RCWO  
08-18-66  
CONSERVATION DIVISION  
WICHITA, KANSAS

Describe in detail the manner in which the well was plugged, indicating where the mud fluid was placed and the method or methods used in introducing it into the hole. If cement or other plugs were used, state the character of same and depth placed, from \_\_\_\_\_ feet to \_\_\_\_\_ feet for each plug set.

8 5/8" 996' circulated with cement - 2 1/2" tubing for oil string 3318'-perf 3188' - top cement on survey 2500' - cut tubing off at 2490' - circulated hole with heavy mud through 2 1/2" (40 sacks Gel), pulled tubing to 445' displaced 20 sacks cement through 2 1/2" at 445', heavy mud to 160', displaced 20 sacks cement through 2 1/2" at 160', heavy mud to 35', filled hole with cement 35' to bottom of cellar.

Mudding and cementing by Halliburton Cementing Company

(If additional description is necessary, use BACK of this sheet)  
Name of Plugging Contractor White & Fry & Halliburton Cementing Company  
Address 201 Mobil Bldg., Wichita, Kansas

STATE OF Kansas, COUNTY OF Sedgewick, ss.  
Walter Fry (employee of owner) or (owner or operator) of the above-described well, being first duly sworn on oath, says: That I have knowledge of the facts, statements, and matters herein contained and the log of the above-described well as filed and that the same are true and correct. So help me God.

(Signature) [Signature]  
(Address) [Address]

SUBSCRIBED AND SWORN to before me this 17 day of August, 1966  
My commission expires October 20, 1969  
Notary Public.

