


STATE OF KANSAS
STATE CORPORATION COMMISSION

WELL PLUGGING RECORD

Give All Information Completely
Make Required Affidavit
Mail or Deliver Report to
Conservation Division
State Corporation Comm.
245 North Water
Wichita, KS 67202

Ellis County. Sec. 16 Twp. 11 Rge. 16 E/W
Location as "NE/CNW $\frac{1}{4}$ SW $\frac{1}{4}$ " or footage from lines _____
SW NE SE
Lease Owner Chief Drilling Company
Lease Name Lundy #2 Well No. _____
Office Address Wichita, Kansas 67202
Character of Well (Completed as Oil, Gas or Dry Hole) _____

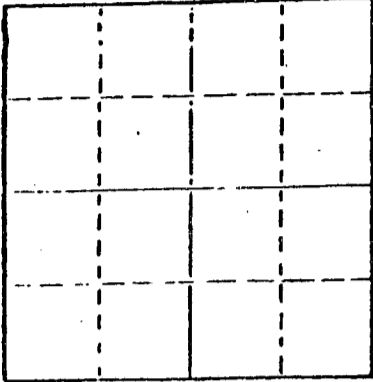

Date Well completed _____ 19____
Application for plugging filed _____ 19____
Application for plugging approved _____ 19____
Plugging commenced 12/29/78 _____ 19____
Plugging completed 1/5/79 _____ 19____
Reason for abandonment of well or producing formation _____
depleted
If a producing well is abandoned, date of last production _____ 19____

Was permission obtained from the Conservation Division or its agents before plugging was commenced? yes

Name of Conservation Agent who supervised plugging of this well Massey
Producing formation _____ Depth to top _____ Bottom _____ Total Depth of Well 3460
Show depth and thickness of all water, oil and gas formations.

OIL, GAS OR WATER RECORDS

CASING RECORD

FORMATION	CONTENT	FROM	TO	SIZE	PUT IN	PULLED OUT
				8-5/8	270	none
				5 1/2"	3430	484

Describe in detail the manner in which the well was plugged, indicating where the mud fluid was placed and the method or methods used in introducing it into the hold. If cement or other plugs were used, state the character of same and depth placed, from _____ feet to _____ feet for each plug set.

Sanded to 3000' and ran 4 sacks cement. Loaded hole, shot pipe at 806', 605', 486', pulled 13 joints. Squeezed well with 10 sacks gel, 1 sack hulls, plug and 120 sacks pos, 2% gel.

PLUGGING COMPLETE.

(If additional description is necessary, use BACK of this sheet)
Name of Plugging Contractor KELSO CASING PULLING
CHASE, KANSAS

RECEIVED
STATE CORPORATION COMMISSION
JAN 15 1979
01-15-79
RWD

STATE OF KANSAS COUNTY OF RICE
R. DARRELL KELSO (employee of owner or operator)
of the above-described well, being first duly sworn on oath, says: That, to his knowledge of the facts, statements, and matters herein contained and the log of the above-described well as filed and that the same are true and correct. So help me God.

(Signature) R. Darrell Kelso
CHASE, KANSAS
(Address)

SUBSCRIBED AND SWORN TO before me this 11th day of Jan., 1979

My commission expires _____



Margaret Melcher
Notary Public.

W E L L L O G

15-051-01107-0000

Houston Petroleum Company
411 Union National Building
Wichita, Kansas

Chief Drilling Company, Inc.
P. O. Box 97
Great Bend, Kansas

Lundy No. 2
SW NE SE Sec. 16-11S-16W
Ellis County, Kansas

Contractor: Chief Drilling Company, Inc.
Rotary : 0 to 3460' Total Depth

Commenced: 10-7-59
Completed: 10-18-59

Casing Record. 8 5/8" set @ 270' with 175 sacks. Cement circulated.
5 1/2" set @ 3430' with 600 gal. laytex and 35 sacks cement.

<u>FORMATION</u>	<u>FROM</u>	<u>TO</u>	<u>FORMATION TOPS</u>	
Shale, clay and shells	0	268	Anhydrite	980 (+ 845)
Shale, shells and sand streaks	268	770	Topeka	2737 (- 912)
Shale and shells	770	979	Heebner	2977 (-1152)
Anhydrite	979	1017	Toronto	2998 (-1173)
Shale and shells	1017	1750	Lansing-Kansas City	3026 (-1201)
Lime and shale	1750	1980	Base-Kansas City	3270 (-1445)
Shale and sand	1980	2195	Cherty-Conglomerate	3337 (-1512)
Shale and Lime	2195	2737	Simpson	3367 (-1542)
Lime	2737	2977	Arbuckle	3409 (-1584)
Lime and shale streaks	2977	3026	Total Depth	3460 (-1635)
Lime	3026	3270		
Broken Lime and shale	3270	3337		
Cherty Lime	3337	3367		
Shale	3367	3409		
Dolomite	3409	3460		

3460 T. D.

State of Kansas)
County of Barton) ss

I hereby certify that the above is a true and correct copy of the Driller's Log of the well drilled in the SW NE SE of Section 16, Township 11 South, Range 16 West, Ellis County, Kansas to the best of my knowledge and belief.

CHIEF DRILLING COMPANY, INC.

V. Richard Hoover
V. Richard Hoover, President

Subscribed and sworn to before me this 22nd day of October, 1959.

Carolyn B. Stueve
Carolyn B. Stueve, Notary Public

My Commission Expires: June 1, 1963