

CARD MUST BE TYPED

State of Kansas  
**NOTICE OF INTENTION TO DRILL**  
(see rules on reverse side)

CARD MUST BE SIGNED

Starting Date: ..... 3 ..... 26 ..... 85 .....  
month day year

API Number 15- 051-01,031-00-01

OPERATOR: License # 6772

.SW. . NE . NW Sec . 8 . Twp . 11 S, Rge . 16.  East  
(location)  West

Name V. Francis Weigel

Address Box 244

City/State/Zip Gorham, Kansas 67640

Contact Person V. Francis Weigel

Phone 913-637-5383

4290..... Ft North from Southeast Corner of Section

3630..... Ft West from Southeast Corner of Section

(Note: Locate well on Section Plat on reverse side)

CONTRACTOR: License # 5655

Nearest lease or unit boundary line ..... 990 ..... feet.

County Ellis

Name Shields Drlg. Co., Inc.

Lease Name Chesney "B" Well# 10

City/State Russell, Kansas 67665

Domestic well within 330 feet:  yes  no

Municipal well within one mile:  yes  no

Well Drilled For: Well Class: Type Equipment:

- Oil  Swd  Infield  Mud Rotary
- Gas  Inj  Pool Ext.  Air Rotary
- OWWO  Expl  Wildcat  Cable

Depth to Bottom of fresh water ..... 125 ..... feet

Lowest usable water formation ... Dakota SS.....

Depth to Bottom of usable water ..... 700 ..... feet

If OWWO: old well info as follows:

Operator Harold Krueger

Well Name Chesney #1

Comp Date 7-12-57. Old Total Depth 3495

Surface pipe by Alternate: 1  2

Surface pipe to be set .. Already Set @ 206..... feet

Conductor pipe if any required ..... None ..... feet

Projected Total Depth ..... 3700 ..... feet

Ground surface elevation ..... 1881 ..... feet MSL

Projected Formation at TD ..... Arbuckle.....

This Authorization Expires 9-15-85

Expected Producing Formations Disposal

Approved By 3-15-85 [Signature]

I certify that we will comply with K.S.A. 55-101, et seq., plus eventually plugging hole to K.C.C. specifications.


Date ..... Signature of Operator or Agent [Signature] Title

[Signature]

Must be filed with the K.C.C. five (5) days prior to commencing well  
This card void if drilling not started within six (6) months of date received by K.C.C.

**Important procedures to follow :**

**A Regular Section of Land  
1 Mile = 5,280 Ft.**

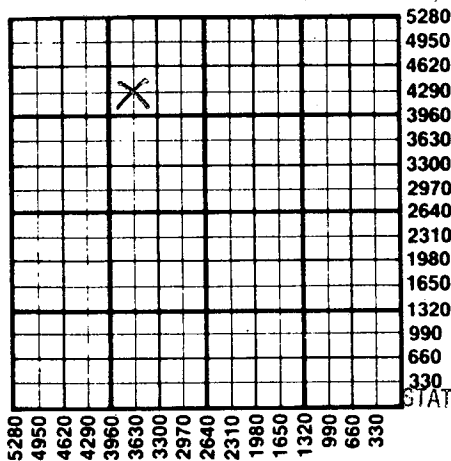

1. Notify District office before setting surface casing.
2. Set surface casing by circulating cement to the top.
3. File completion forms ACO-1 with K.C.C. within 90 days of well completion, following instructions on ACO-1, side 1, and including copies of wireline logs.
4. Notify District office 48 hours prior to old well workover or re-entry.
5. Prior to plugging, prepare a plugging plan, then obtain agreement from the appropriate district office for an approved plugging plan.
6. Submit plugging report (CP-4) to K.C.C. after plugging is completed.
7. Obtain an approved injection docket number before disposing of salt water.
8. Notify K.C.C. within 10 days when injection commences or terminates.

RECEIVED  
STATE CORPORATION COMMISSION  
If an alternate 2 completion, cement in the production pipe from below and usable water to surface within 120 days of spud date.

MAR 15 1985

CONSERVATION DIVISION  
Wichita, Kansas

State Corporation Commission of Kansas  
Conservation Division  
200 Colorado Derby Building  
Wichita, Kansas 67202  
(316) 263-3238