

CARD MUST BE TYPED

NOTICE OF INTENTION TO DRILL

(see rules on reverse side)

CARD MUST BE SIGNED

Starting Date: December 1 1985
month day year

API Number 15- 051-24,355-0000

East

OPERATOR: License # 6772

.SE. . SW .NW Sec . 8 . Twp . 11 S, Rge . 16. West
(location)

Name V. Francis Weigel

Address Box 244

City/State/Zip Gorham, Kansas 67640

Contact Person V. Francis Weigel

Phone 913-637-5383

29.70 Ft North from Southeast Corner of Section
4290 Ft West from Southeast Corner of Section
(Note: Locate well on Section Plat on reverse side)

CONTRACTOR: License # 5655

Name Shields Drilling Co., Inc

City/State Russell, Kansas 67665

Nearest lease or unit boundary line 330 feet.

County Ellis

Lease Name Chesney, B. Well# 11

Domestic well within 330 feet : yes no

Municipal well within one mile : yes no

Well Drilled For: Well Class: Type Equipment:

- Oil Swd Infield Mud Rotary
- Gas Inj Pool Ext. Air Rotary
- OWWO Expl Wildcat Cable

Depth to Bottom of fresh water 100 feet

Lowest usable water formation Dakota SS

Depth to Bottom of usable water 100 750 feet

Surface pipe by Alternate : 1 2

Surface pipe to be set 800 feet

Conductor pipe if any required None feet

Ground surface elevation est. 1900 feet MSL

This Authorization Expires 5-12-86

Approved By 11-12-85 *FC*

If OWWO: old well info as follows:

Operator

Well Name

Comp Date Old Total Depth

Projected Total Depth feet

Projected Formation at TD

Expected Producing Formations

I certify that we will comply with K.S.A. 55-101, et seq., plus eventually plugging hole to K.C.C. specifications.

Date 11-8-85 Signature of Operator or Agent


V. Francis Weigel

Title Owner

Must be filed with the K.C.C. five (5) days prior to commencing well
This card void if drilling not started within six (6) months of date received by K.C.C.

Important procedures to follow :

**A Regular Section of Land
1 Mile = 5,280 Ft.**

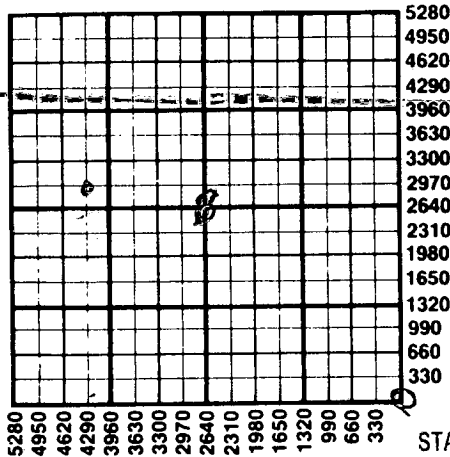

1. Notify District office before setting surface casing.
2. Set surface casing by circulating cement to the top.
3. File completion forms ACO-1 with K.C.C. within 90 days of well completion, following instructions on ACO-1, side 1, and including copies of wireline logs.
4. Notify District office 48 hours prior to old well workover or re-entry.
5. Prior to plugging, prepare a plugging plan, then obtain agreement from the appropriate district office for an approved plugging plan.
6. Submit plugging report (CP-4) to K.C.C. after plugging is completed.
7. Obtain an approved injection docket number before disposing of salt water.
8. Notify K.C.C. within 10 days when injection commences or terminates.
9. If an alternate 2 completion, cement in the production pipe from below any usable water to surface within 120 days of spud date.

RECEIVED

STATE CORPORATION COMMISSION

State Corporation Commission of Kansas

Conservation Division

200 Colorado Derby Building

Wichita, Kansas 67202

(316) 263-3238

NOV 12 1985

CONSERVATION DIVISION

Wichita, Kansas