

NOTICE OF INTENTION TO DRILL

(see rules on reverse side)

owwo  
VO

Starting Date ..... 2-22-88  
month day year

API Number 15-05120,903-0001

OPERATOR: License # 6725  
Name Eric Waddell Company  
Address Box 349  
City/State/Zip Natoma KS 67651  
Contact Person Eric Waddell  
Phone 913-885-4497

SE. SE. SW. Sec. 9... Twp. 11S. S. Rg. 16W.  East  
 West  
330 ..... Ft. from South Line of Section  
2970 ..... Ft. from East Line of Section

(Note: Locate well on Section Plat on reverse side)

CONTRACTOR: License #  
Name  
City/State

Nearest lease or unit boundary line ..... 330 ..... feet  
County Ellis

Well Drilled For: Well Class: Type Equipment:  
 Oil  SWD  Infield  Mud Rotary  
 Gas  Inj  Pool Ext.  Air Rotary  
 OWWO  Expl  Wildcat  Cable

Lease Name Craig "B" Well # 1 "owwo"  
Ground surface elevation ..... 1807 ..... feet MSL  
Domestic well within 330 feet:  yes  no  
Municipal well within one mile:  yes  no  
Surface pipe by Alternate: 1  2

If OWWO: old well info as follows:  
Operator F&M Oil Co.  
Well Name Craig #1  
Comp Date 6-20-73 Old Total Depth 3430

Depth to bottom of fresh water ..... 100 .....  
Depth to bottom of usable water ..... 700 .....  
Surface pipe planned to be set ..... 222 .....  
Projected Total Depth ..... 3430 ..... feet  
Formation Arbuckle

I certify that well will comply with K.S.A. 55-101, et seq., plus eventually plugging hole to KCC specifications.

\_\_\_\_\_ cementing will be done immediately upon setting production casing.  
Date 2-18-88 Signature of Operator or Agent Title geologist


For KCC Use:  
Conductor Pipe Required ..... feet; Minimum Surface Pipe Required ..... 222 ..... feet per Alt. X 2  
This Authorization Expires 8-19-88 EFFECTIVE 2-24-88 Approved By [Signature] 2-19-88

Must be filed with the K.C.C. five (5) days prior to commencing well  
This card void if drilling not started within six (6) months of date received by K.C.C.

### Important procedures to follow:

1. Notify District office before setting surface casing.
2. Set surface casing by circulating cement to the top.
3. File completion forms ACO-1 with K.C.C. within 90 days of well completion, following instructions on ACO-1, side 1, and including copies of wireline logs.
4. Notify District office 48 hours prior to old well workover or re-entry.
5. Prior to filing Intent, prepare a proposed plugging plan in case well is D & A, then obtain approval of plan when calling district office prior to setting surface pipe.
6. Submit plugging report (CP-4) to K.C.C. after plugging is completed.
7. Obtain an approved injection docket number before disposing of salt water.
8. Notify K.C.C. within 10 days when injection commences or terminates.
9. If an alternate 2 completion, cement in the production pipe from below any usable water to surface within 120 days of spud date.

### A Regular Section of Land 1 Mile = 5,280 Ft.

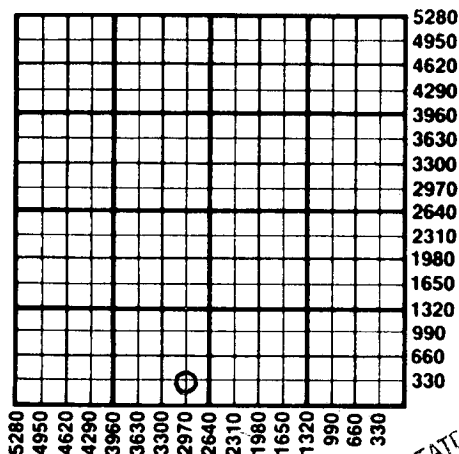

RECEIVED  
STATE CORPORATION COMMISSION  
Feb 19 9 1988  
CONSERVATION DIVISION  
Wichita, Kansas

02-19-88

State Corporation Commission of Kansas  
Conservation Division  
200 Colorado Derby Building  
Wichita, Kansas 67202  
(316) 263-3238