

CARD MUST BE TYPED

State of Kansas
NOTICE OF INTENTION TO DRILL
(see rules on reverse side)

CARD MUST BE SIGNED

Starting Date: November 15, 1984
month day year

API Number 15- 051-24,080-0000

OPERATOR: License # 5447

..... NE. NW. NE. Sec. 24. Twp. 11. S. Rge. 17. East
(location) West

Name Cities Service Oil & Gas Corporation

Address 800 Sutton Place Bldg., 209 E. William

City/State/Zip Wichita, Kansas 67202

Contact Person David Juby

Phone 316 265-5624

..... 4620 Ft North from Southeast Corner of Section

..... 1600 Ft West from Southeast Corner of Section

(Note: Locate well on Section Plat on reverse side)

CONTRACTOR: License # 5302

Name Red Tiger Drilling Company

City/State 1720 Ks. State Bank Bldg., Wichita, KS

67202

Nearest lease or unit boundary line 1600 feet.

County Ellis

Lease Name Colahan "A" Well# 37 SWD

Domestic well within 330 feet: yes no

Municipal well within one mile: yes no

Well Drilled For: Well Class: Type Equipment:

- Oil Swd Infield Mud Rotary
- Gas Inj Pool Ext. Air Rotary
- OWWO Expl Wildcat Cable

If OWWO: old well info as follows:

Operator

Well Name

Comp Date Old Total Depth

Projected Total Depth 3900 feet

Projected Formation at TD Arbuckle

Expected Producing Formations

Depth to Bottom of fresh water 60 feet

Lowest usable water formation Dakota

Depth to Bottom of usable water 700 feet

Surface pipe by Alternate: 1 2

Surface pipe to be set 200 feet

Conductor pipe if any required - feet

Ground surface elevation 1885 feet MSL

This Authorization Expires 5-5-85

Approved By 11-5-84 [Signature]

I certify that we will comply with K.S.A. 55-101, et seq., plus eventually plugging hole to K.C.C. specifications.

Date 10-31-84

Signature of Operator or Agent [Signature] Title Engineering Technician
David D. Juby

Engineering Technician

Form C-1 4/84

MHC/KOHE 11/5/84

Must be filed with the K.C.C. five (5) days prior to commencing well
This card void if drilling not started within six (6) months of date received by K.C.C.

RECEIVED
STATE CORPORATION COMMISSION

NOV 05 1984


WICHITA, KANSAS

11-05-84

Important procedures to follow:

1. Notify District office before setting surface casing.
2. Set surface casing by circulating cement to the top.
3. File completion forms ACO-1 with K.C.C. within 90 days of well completion, following instructions on ACO-1, side 1, and including copies of wireline logs.
4. Notify District office 48 hours prior to old well workover or re-entry.
5. Prior to plugging, prepare a plugging plan, then obtain agreement from the appropriate district office for an approved plugging plan.
6. Submit plugging report (CP-4) to K.C.C. after plugging is completed.
7. Obtain an approved injection docket number before disposing of salt water.
8. Notify K.C.C. within 10 days when injection commences or terminates.
9. If an alternate 2 completion, cement in the production pipe from below any usable water to surface within 120 days of spud date.

**A Regular Section of Land
1 Mile = 5,280 Ft.**

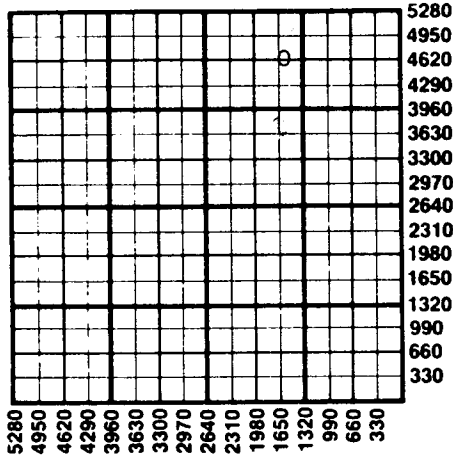

State Corporation Commission of Kansas
Conservation Division
200 Colorado Derby Building
Wichita, Kansas 67202
(316) 263-3238