

NOTICE OF INTENTION TO DRILL

(see rules on reverse side)

Starting Date January 2, 1985
month day year

API Number 15-193-20390-0000

OPERATOR: License # 5181
Name SLAWSON, DONALD C.
Address 200 Douglas Building
City/State/Zip Wichita, Kansas 67202
Contact Person Bill Horigan
Phone (316) 263-3201

NE NE NE Sec. 31 Twp. 10 S, Rg 32
4950' Ft. from South Line of Section
330' Ft. from East Line of Section

(Note: Locate well on Section Plat on reverse side)

CONTRACTOR: License # 5657
Name Slawson Drilling Co.
City/State Great Bend, Kansas

Nearest lease or unit boundary line 330' feet
County Thomas
Lease Name Hecker 'G' Well # 1
Ground surface elevation 3064 GR. (SEIS) feet MSL

Well Drilled For: Well Class: Type Equipment:
[X] Oil SWD Infield [X] Mud Rotary
Gas Inj [X] Pool Ext. Air Rotary
OWWO Expl Wildcat Cable

Domestic well within 330 feet: yes no
Municipal well within one mile: yes no
Surface pipe by Alternate: 1 2 [X]
Depth to bottom of fresh water 180'
Depth to bottom of usable water 1700'
Surface pipe planned to be set 320'
Projected Total Depth 4700' feet
Formation Mississippian

If OWWO: old well info as follows:

Operator
Well Name
Comp Date Old Total Depth

I certify that well will comply with K.S.A. 55-101, et seq., plus eventually plugging hole to KCC specifications.

cementing will be done immediately upon setting production casing.

Date 12/31/85 Signature of Operator or Agent Robert B. Jenkins Title Geologist Kansas Western District

For KCC Use:

Conductor Pipe Required feet; Minimum Surface Pipe Required 250 feet per Alt. 1 2

This Authorization Expires 7-1-86 Approved By Pott 12-31-85

Must be filed with the K.C.C. five (5) days prior to commencing well  
 This card void if drilling not started within six (6) months of date received by K.C.C.

RECEIVED  
 STATE CORPORATION COMMISSION


Important procedures to follow:

DEC 31 1985

A Regular Section of Land  
 1 Mile = 5,280 Ft.

CONSERVATION DIVISION

1. Notify District office before setting surface casing.
2. Set surface casing by circulating cement to the top.
3. File completion forms ACO-1 with K.C.C. within 90 days of well completion, following instructions on ACO-1, side 1, and including copies of wireline logs.
4. Notify District office 48 hours prior to old well workover or re-entry.
5. Prior to filing Intent, prepare a proposed plugging plan in case well is D & A, then obtain approval of plan when calling district office prior to setting surface pipe.
6. Submit plugging report (CP-4) to K.C.C. after plugging is completed.
7. Obtain an approved injection docket number before disposing of salt water.
8. Notify K.C.C. within 10 days when injection commences or terminates.
9. If an alternate 2 completion, cement in the production pipe from below any usable water to surface within 120 days of spud date.

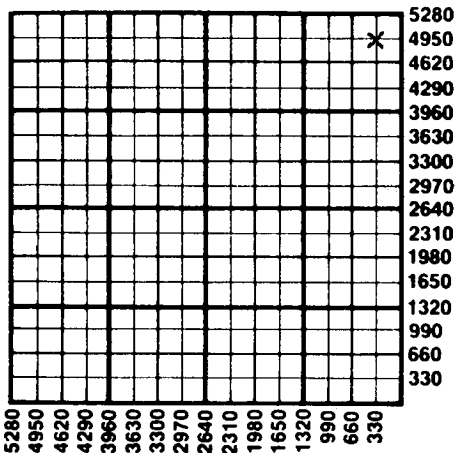

State Corporation Commission of Kansas  
 Conservation Division  
 200 Colorado Derby Building  
 Wichita, Kansas 67202  
 (316) 263-3238