


15-051-19235-0000

STATE OF KANSAS
STATE CORPORATION COMMISSION

Give All Information Completely
Make Required Affidavit
Mail or Deliver Report to:
Conservation Division
State Corporation Commission
800 Bitting Building
Wichita, Kansas

WELL PLUGGING RECORD

NORTH

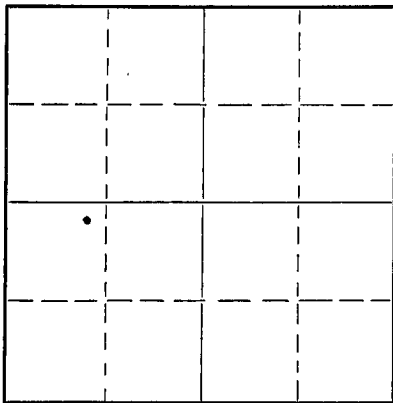

Locate well correctly on above
Section Plat

Ellis County, Sec. 10 Twp. 13S Rge. 17 (W)

Location as "NE/CNW $\frac{1}{4}$ /SW $\frac{1}{4}$ " or footage from lines NE NW SW
Lease Owner Anschutz Drilling Company, Inc.
Lease Name Dorzweiler Well No. 1
Office Address 1307 $\frac{1}{2}$ Main Street, Great Bend, Kansas
Character of Well (completed as Oil, Gas or Dry Hole) Dry Hole
Date well completed February 18 19 51
Application for plugging filed March 28 19 51
Application for plugging approved March 31 19 51
Plugging commenced April 14 19 51
Plugging completed April 17 19 51
Reason for abandonment of well or producing formation Lack of sufficient prod.

If a producing well is abandoned, date of last production March 12 19 51
Was permission obtained from the Conservation Division or its agents before plugging was commenced? Yes

Name of Conservation Agent who supervised plugging of this well Eldon Petty
Producing formation Arbuckle Depth to top 3525' Bottom 3541' Total Depth of Well 3541' Feet
Show depth and thickness of all water, oil and gas formations.

OIL, GAS OR WATER RECORDS

CASING RECORD

Formation	Content	From	To	Size	Put In	Pulled Out
Arbuckle	Water with show of oil	3525'	3541'	5 $\frac{1}{2}$ "	3526 $\frac{1}{2}$ '	2630'

Describe in detail the manner in which the well was plugged, indicating where the mud fluid was placed and the method or methods used in introducing it into the hole. If cement or other plugs were used, state the character of same and depth placed, from.....feet to.....feet for each plug set.

Lane Wells cast iron bridging plug 3447 $\frac{1}{2}$ '

Chat 3447 $\frac{1}{2}$ ' - 3330'

Cement 3330' - 3295'

Mudded back to 210'

Rock bridge to 200' - dumped 15 sacks cement at 200' and mudded to 35'. 10' rock bridge at 35' and dumped 10 sacks cement filling hole to top.

RECEIVED
STATE CORPORATION COMMISSION
APR 21 1951
CONSERVATION DIVISION
Wichita, Kansas

(If additional description is necessary, use BACK of this sheet)

Correspondence regarding this well should be addressed to Anschutz Drilling Company, Inc.
Address 1307 $\frac{1}{2}$ Main Street
Great Bend, Kansas


STATE OF KANSAS, COUNTY OF BARTON, ss.
Edw. C. Myers, Jr. (employee of owner) or (owner or operator) of the above-described well,
being first duly sworn on oath, says: That I have knowledge of the facts, statements, and matters herein contained and the log of the above-described well as filed and that the same are true and correct. So help me God.

(Signature) Edw. C. Myers, Jr.
1307 $\frac{1}{2}$ Main Street, Great Bend, Kansas
(Address)

SUBSCRIBED AND SWORN TO before me this 20th day of April, 19 51.

My commission expires July 21, 1954 Notary Public.

22-7877-s 4-49-10M

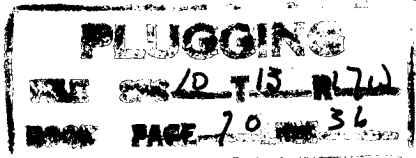

FRED B. ANSCHUTZ
 #1 DORZWEILER
 NE NW SW - SECTION 10-135-17W
 ELLIS COUNTY, KANSAS

0	40	Surface clay
40	244	Shale & shells
244	250	Shale & shells
250	735	Shale & shells
735	835	Sand
835	885	Shale & shells
885	970	Shale & shells
970	1190	Red Rock
1190	1200	Anhydrite
1200	1230	Anhydrite
1230	1450	Shale & shells
1450	1780	Shale & shells
1780	1970	Shale & shells
1970	2095	Shale & lime
2095	2195	Lime & shale
2195	2300	Lime & shale
2300	2420	Shale & lime
2420	2500	Lime & shale
2500	2600	Lime & shale
2600	2710	Lime & shale
2710	3104	Shale & lime
3104	3198	Lime & shale
3198	3255	Lime
3255	3305	Lime & shale
3305	3343	Lime
3343	3356	Lime
3356	3370	Lime
3370	3418	Lime
3418	3474	Lime
3474	3522	Lime
3522	3526	Lime
3526	3529	Arbuckle
3529		ROTARY TOTAL DEPTH

COMMENCED: 1/16/51
 COMPLETED: 1/27/51

TOPS:

Top.	2984
Heeb.	3226
Top.	3248
Lens-KC	3270
Arb.	3526 (-1516)
RTD	3529 (-1519)

CASING RECORD:
 Set 8-5/8" surface casing @ 238' with 150 sacks cement.
 Set 5-1/2" oil string of casing @ 3527 1/2' with 150 sacks cement

STATE OF KANSAS)
) 55
 COUNTY OF SEDGWICK)

I hereby affirm that the above and foregoing is a true and correct copy of the log of the #1 Dorzweiler located in the NE NW SW of Section 10-135-17W, Ellis County, Kansas.

ANSCHUTZ DRILLING COMPANY, INC.

BY: *H. R. Jensen*
 H. R. Jensen

Subscribed and sworn to before me this 5th day of February, 1951.

Laurie Decker
 Notary Public

My commission expires January 21, 1954.

RECEIVED
 STATE CORPORATION COMMISSION
 MAY 10 1951
 CONSERVATION DIVISION
 Wichita, Kansas

PLUGGING
 FILE SEC 10 T 13 R 17 W
 BOOK PAGE 70 LINE 36