


STATE OF KANSAS
STATE CORPORATION COMMISSION

WELL PLUGGING RECORD

Give All Information Completely
Make Required Affidavit
Mail or Deliver Report to
Conservation Division
State Corporation Comm.
245 North Water
Wichita, KS 67202

Ellis County, Sec. 10 Twp. 13S Rge. 17 E/W
Location as "NE/CNW 1/4 SW 1/4" or footage from lines
1650' FSL & 330' FEL
Lease Owner Kewanee Oil Company
Lease Name Catherine Unit Tract 3 Well No. 7
Office Address P.O. Box 2093, Wichita, Kansas 67201
Character of Well (Completed as Oil, Gas or Dry Hole)

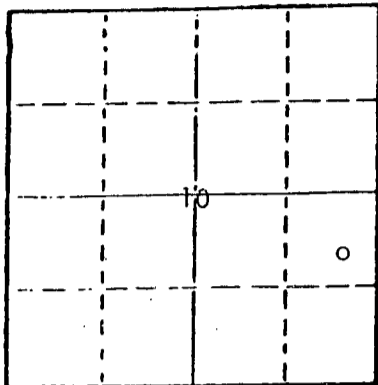

Locate well correctly on above
Section Plat

Oil Well
Date Well completed 9-19 19 57
Application for plugging filed 11-11 19 76
Application for plugging approved 11-12 19 76
Plugging commenced 11-15 19 76
Plugging completed 11-15 19 76
Reason for abandonment of well or producing formation
Uneconomical - production depleted
If a producing well is abandoned, date of last production
April 13, 19 70

Was permission obtained from the Conservation Division or
its agents before plugging was commenced? Yes

Name of Conservation Agent who supervised plugging of this well Leo Massey
Producing formation Arbuckle Depth to top 3501 Bottom 3510 Total Depth of Well 3510
Show depth and thickness of all water, oil and gas formations.

OIL, GAS OR WATER RECORDS

CASING RECORD

FORMATION	CONTENT	FROM	TO	SIZE	PUT IN	PULLED OUT
				8-5/8	237	None
				5-1/2	3507	None

Describe in detail the manner in which the well was plugged, indicating where the mud fluid
was placed and the method or methods used in introducing it into the hold. If cement or other
plugs were used, state the character of same and depth placed, from _____ feet to
_____ feet for each plug set.

Spotted 5 sacks gel & 1 sack hulls followed by 100 sacks regular cement, 4% gel.
Squeezed down bradenhead with 50 sacks. Capped well with 1/4" plate. Plugging
done as per instructions from Leo Massey, State Plugger, who was on location
throughout plugging operation.

12-2-76
683021570

(If additional description is necessary, use BACK of this sheet)

Name of Plugging Contractor Rapid Well Service

STATE OF Kansas COUNTY OF Sedgwick, ss.
C. W. Mosier (employee of owner) ~~owner or operator~~
of the above-described well, being first duly sworn on oath, says: That I have knowledge of
the facts, statements, and matters herein contained and the log of the above-described well
as filed and that the same are true and correct. So help me God.


(Signature)

P. O. Box 2093, Wichita, Kansas 67201
(Address)

1st day of December, 1976

Billie Oden Notary Public.

My commission expires August 10, 1979

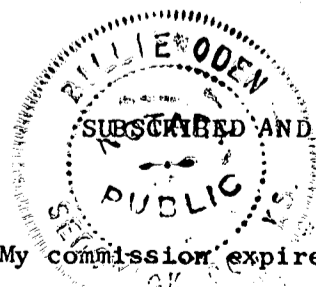

KEWANEE OIL COMPANYWest Kansas District

Well Record: Giebler "B" #7 (Catherine Unit #3-7)

Location: SE NE SE Sec. 10-13-17W, Ellis County, Kansas.

Elevation: 2000'

Drilling Commenced: 9-1-57

Drilling Completed: 9-11-57

Completion Date: 9-19-57

Total Depth: 3510'

Producing Interval: OH 3507-10'

Initial Treatment: None

Initial Potential: ??

FORMATION TOPS

Anhydrite	1160	+ 840
Lansing-Kansas City	3244	-1244
Conglomerate	3494	-1494
Arbuckle	3501	-1501
Total Depth	3510	-1510

NOV 12 1957

M.B.

CASING RECORD

8-5/8", 237', cemented w/130 sacks.

5-1/2", 3507', cemented w/100 sacks set @ 3503'.

DST RECORDDST #1 - Toronto 3206-3235'. Open 30 min, weak blow 5 min. Recovered 12' mud, no shows. BHP zero.DST #2 - 3264-3308'. Open 1 hr., weak blow 30 minutes, intermittent blow 30 min. Recovered 90' SO & GCM.DST #3 - 3308-3350'. Open 1 hr., good blow. Recovered 810' gas, 70' oily mud, 120' muddy oil, 185' VG froggy oil. IBHP 400#/20 minutes.DST #4 - 3372-3430'. Open 1 hr., weak steady blow. Recovered 33' SOCM (poor). IBHP 298#/20 minutes.DST #5 - 3504-10'. Open 1 hr., strong steady blow, Recovered 1320' oil, 60' muddy water. BHP 700#/20 minutes.COMPLETION RECORD

9-15-57 MICT. CO to TD 3510'.

9-19-57 Completed in Arbuckle.