


WELL PLUGGING RECORD

Give All Information Completely
Make Required Affidavit
Mail or Deliver Report to:
Conservation Division
State Corporation Commission
800 Bitting Building
Wichita, Kansas

Ellis County. Sec. 10 Twp. 13S. Rge. 17W (E) (W)
Location as "NE/CNW $\frac{1}{4}$ SW $\frac{1}{4}$ " or footage from lines C S/2 NW/4 NE/4
Lease Owner Anderson-Prichard Oil Corporation
Lease Name Walter Well No. 1
Office Address 1000 Apco Tower, Oklahoma City 2, Oklahoma
Character of Well (completed as Oil, Gas or Dry Hole) Dry Hole
Date well completed May 13 1950
Application for plugging filed May 12 1950
Application for plugging approved May 12 1950
Plugging commenced May 13 1950
Plugging completed May 13 1950
Reason for abandonment of well or producing formation Dry Hole

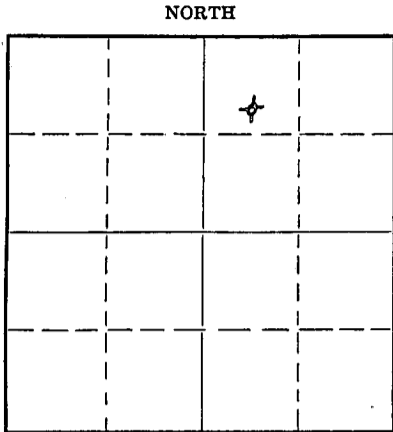

Locate well correctly on above Section Plat

If a producing well is abandoned, date of last production 19
Was permission obtained from the Conservation Division or its agents before plugging was commenced? Yes

Name of Conservation Agent who supervised plugging of this well E. R. Petty
Producing formation Depth to top Bottom Total Depth of Well 3581' Feet
Show depth and thickness of all water, oil and gas formations.

OIL, GAS OR WATER RECORDS

CASING RECORD

Formation	Content	From	To	Size	Put In	Pulled Out
		●	1185	8 5/8	1185	None

Describe in detail the manner in which the well was plugged, indicating where the mud fluid was placed and the method or methods used in introducing it into the hole. If cement or other plugs were used, state the character of same and depth placed, from feet to feet for each plug set.

3581' - 251 $\frac{1}{2}$ ' - Heavy Rotary Mud
251 $\frac{1}{2}$ ' - 250' - Wooden Plug
250' - 203' - 15 sacks cement
203' - 36 $\frac{1}{2}$ ' - Heavy Rotary Mud
36 $\frac{1}{2}$ ' - 35' - Wooden Plug
35' - 6' - 10 sacks cement
6' - Surface - Cellar

RECEIVED
Conservation Div.
MAY 26 1950
STATE CORPORATION
COMMISSION
KANSAS

(If additional description is necessary, use BACK of this sheet)

Correspondence regarding this well should be addressed to Anderson-Prichard Oil Corporation
Address 1000 Apco Tower, Oklahoma City 2, Oklahoma

STATE OF Kansas, COUNTY OF Barton, ss.

Glenn Peel Drilling Co., Inc. (employee of owner) or (owner/operator) of the above-described well, being first duly sworn on oath, says: That I have knowledge of the facts, statements, and matters herein contained and the log of the above-described well as filed and that the same are true and correct. So help me God. GLENN PEEL DRILLING COMPANY, INC.


(Signature) BY: *Glenn Peel*

P. O. Box 359, Hoisington, Kansas
(Address)

SUBSCRIBED AND SWORN TO before me this 24th day of May, 1950

Marion M. Herbert
Notary Public.

My commission expires June 4, 1951

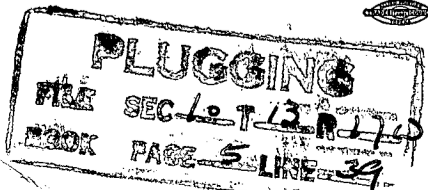

15-051-04509-0000

DRILLER'S LOG

Company: Anderson-Prichard Oil Corp.

Sec. 10, Twp. 13S, Rge 17W
C S/2 NW/4 NE/4

Farm: Walter Well No. 1

Total Depth: 3581'

County: Ellis
Kansas

Comm.: 4-27-50 Comp.: 5-13-50
Contractor: Glenn Peel Drilling Co., Inc.

Elevation:

Casing: 8 5/8" 1185' cem.

Production: Dry

Figures below indicate bottom of formations

Surface Clay	0 -	22
Shale and Shells		357
Sand		365
Shale and Shells		414
Sand		571
Shale		700
Sand		815
Shale and Red Bed and Shells		1170
Anhydrite		1215
Red Bed and Shale		1455
Shale and Shells		1800
Lime		1874
Shale		1908
Lime		1931
Lime and Shale		2120
Lime		2327
Lime and Shale		2745
Shale		2788
Lime		2816
Shale		2841
Broken Lime		2857
Lime		2862
Shale		2870
Lime and Shale		3045
Lime		3547
Conglomerate		3552
Arbuckle Lime		3557
Arbuckle		3581
Total Depth		3581

This is to certify that the above information is, to the best of our knowledge, true and correct.

GLENN PEEL DRILLING COMPANY, INC.

BY: *Wendell E. Peel*

SUBSCRIBED AND SWORN to before me this 24th day of May, 1950.

My commission expires June 4, 1951

Manan M. Herbert
Notary Public

