


STATE OF KANSAS
STATE CORPORATION COMMISSION
CONSERVATION DIVISION
P. O. BOX 17027
WICHITA, KANSAS 67217

FORM CP-4

WELL PLUGGING RECORD

Ellis County, Sec. 10 Twp. 13S Rge. (E) 17 (W)
Location as "NE/CNW/SE/4" or footage from lines 990 FNL & 1650' FEL SE/4
Lease Owner Kewanee Oil Company
Lease Name Catherine Unit -0- Well No. 3-8WI
Office Address Box 2093, Wichita, Kansas 67201
Character of Well (completed as Oil, Gas or Dry Hole) water input
Date well completed 12-21- 19 63
Application for plugging filed 2-12- 19 75
Application for plugging approved 2-13- 19 75
Plugging commenced 2-20- 19 75
Plugging completed 2-26- 19 75
Reason for abandonment of well or producing formation Well of no further benefit as injection well.
If a producing well is abandoned, date of last production none 19
Was permission obtained from the Conservation Division or its agents before plugging was commenced? Yes

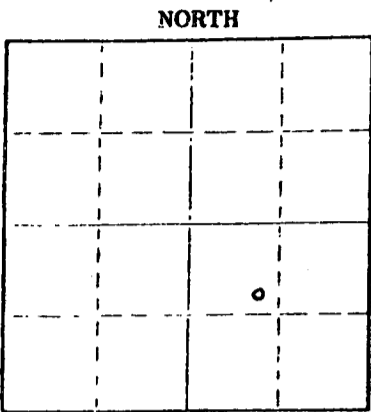

Locate well correctly on above Section Plat

Name of Conservation Agent who supervised plugging of this well Leo Massey
Producing formation Kansas City Depth to top 3268 Bottom Total Depth of Well 3531
Show depth and thickness of all water, oil and gas formations.

OIL, GAS OR WATER RECORDS

CASING RECORD

FORMATION	CONTENT	FROM	TO	SIZE	FUT IN	PULLED OUT
				5 1/2"	3525'	2685'
				8-5/8"	247'	none

Describe in detail the manner in which the well was plugged, indicating where the mud fluid was placed and the method or methods used in introducing it into the hole. If cement or other plugs were used, state the character of same and depth placed, from feet to feet for each plug set.

Made bottom hole plug back with sand to 3300'. Mixed and ran 5 sacks cement thru dump bailer. Squeezed hole with 3 sacks hulls and 20 sacks gel. Released plug and displaced with 130 sacks 50/50 pozmix 6% gel.

(If additional description is necessary, use BACK of this sheet)
Name of Plugging Contractor Southwest Casing Pulling Co.
Address Box 364, Great Bend, Kansas 67530


STATE OF Kansas COUNTY OF Sedgwick ss.
C. W. Mosier (employee of owner) or (PERSON IN CHARGE) of the above-described

being first duly sworn on oath, says: That I have knowledge of the facts, statements, and matters herein contained and the log of the above-described well as filed and that the same are true and correct. So help me God.

(Signature) [Signature] Box 2093, Wichita, Kansas 67201 (Address)

Subscribed and sworn to before me this 7th day of March, 1975

Commission expires 8-10-75 [Signature] Billie Oden Notary Public.

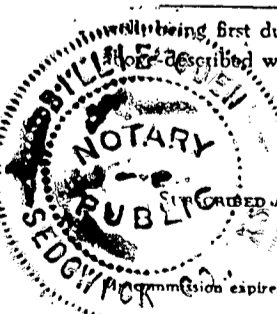

RECEIVED
STATE CORPORATION COMMISSION

MAR 10 1975

CONSERVATION DIVISION
Wichita, Kansas

15-051-04670-0000

KEWANEE OIL COMPANY

Well Record and Sandology: Giebler "B" #8 (AFE N-2230A) Elevation: 2004' C. M.

Location: 990' FNL & 1650' FEL of SE/4 Sec. 10-13S-17W, Ellis County, Kansas.

Drilling Contractor: Woodman-Iannitti Drilling Company

Drilling Commenced: 11-23-63

Drilling Completed: 12-1-63

Completion Date: 12-21-63

Total Depth: 3531' C. M.

PBTD: 3505' C. M.

Initial Production: Injection Well. Injected 379 barrels salt water at 6 BPM and vacuum.

SAMPLE TOPS (C. M.)

Topeka	2959	- 955
Heebner	3222	- 1218
Toronto	3243	- 1239
Douglas	3256	- 1252
Lansing-Kansas City	3270	- 1266
Conglomerate	3524	- 1520
Total Depth	3531	1527

SCHLUMBERGER TOPS (C. M.)

Topeka	2958	- 954
Heebner	3221	- 1217
Toronto	3241	- 1237
Douglas	3256	- 1252
Lansing-Kansas City	3268	- 1264
Conglomerate	3508	- 1504
Total Depth	3531	1527

RECEIVED
STATE CORPORATION COMMISSION

FEB 15 1975

CONSERVATION DIVISION
Wichita, Kansas

FORMATION RECORD

0 - 80	Clay and Sand
255	Shale
575	Shale and Red Bed
1065	Shale
1172	Red Bed
1212	Anhydrite
1475	Shale
1845	Shale and Shells
2085	Shale and Lime
2331	Lime
2460	Shale w/Lime Streaks
2590	Lime
3190	Shale w/Lime Streaks
3535	Lime

CASING RECORD

Cemented 8-5/8" casing @ 247.61' C. M. w/160 sacks, 2% c. c. Cement circulated.
Cemented 5-1/2" casing @ 3525.54' C. M. w/150 cu. ft. pozmix #1 containing 50 cu. ft. Stratacrete #6.