

CARD MUST BE TYPED

CORRECTION ONLY
State of Kansas

CARD MUST BE SIGNED

NOTICE OF INTENTION TO DRILL

(see rules on reverse side)

VDA X

Expected Spud Date..... 3/1/88
month day year

API Number 15— 169-20,296-00-00

OPERATOR: License # 5330

X NW SE _____ East

Name Excalibur Production Co., Inc.

* SE NW NW Sec... 8. Twp... 13 S, Rg. 1... X West

Address P.O. Box 278

3630' Ft. from South Line of Section

City/State/Zip McPherson, Kansas 67460

3630' Ft. from East Line of Section

Contact Person Charles D. Johnson

(Note: Locate well on Section Plat on reverse side)

Phone 1-316-241-1265

Nearest lease or unit boundary line 330' feet

CONTRACTOR: License # 5927

County Saline

Name Blackstone Drilling, Inc.

Lease Name Vaupel Well # 1

City/State P.O. Box 1184, McPherson, Ks. 67460

X Ground surface elevation 1176' feet MSL

Well Drilled For: Well Class: Type Equipment:

Domestic well within 330 feet: ___yes X no

X Oil ___ Storage ___ Infield X Mud Rotary

Municipal well within one mile: ___yes X no

___ Gas ___ Inj ___ Pool Ext. ___ Air Rotary

Depth to bottom of fresh water 100'

___ OWWO ___ Expl X Wildcat ___ Cable

Depth to bottom of usable water 200'

If OWWO: old well info as follows:

Surface pipe by Alternate: 1 X 2

Operator

Surface pipe planned to be set 200'

Well Name

Conductor pipe required N/A

Comp Date Old Total Depth

Projected Total Depth 3200' feet

I certify that well will comply with K.S.A. 55-101, et seq., plus eventually plugging to KCC specifications.

Formation Simpson

Date 2/26/88 Signature of Operator or Agent by [Signature] Title Bookkeeper

For KCC Use:

Conductor Pipe Required _____ feet; Minimum Surface Pipe Required 200 feet per Alt. ① X

This Authorization Expires 8-22-88 Approved By RA 2-29-88 DRIB: RIV 10 2-22-88

X WAS: NW-SE-NE Elev. V/K


* Correcting the legal only. Thank you

Must be filed with the K.C.C. five (5) days prior to commencing well
This card void if drilling not started within six (6) months of date received by K.C.C.

Important procedures to follow:

1. Notify District office before setting surface casing.
2. Set surface casing by circulating cement to the top.
3. File completion forms ACO-1 with K.C.C. within 120 days of well spud date, following instructions on ACO-1, side 1, and including copies of wireline logs.
4. Notify District office 48 hours prior to old well workover or re-entry.
5. Prior to filing Intent, prepare a proposed plugging plan in case well is D & A, then obtain approval of plan when calling district office prior to setting surface pipe.
6. Submit plugging report (CP-4) to K.C.C. after plugging is completed.
7. Obtain an approved injection docket number before disposing of salt water.
8. Notify K.C.C. within 10 days when injection commences or terminates.
9. If an alternate 2 completion, cement in the production pipe from below any usable water to-surface within 120 days of spud date.

A Regular Section of Land
1 Mile = 5,280 Ft.

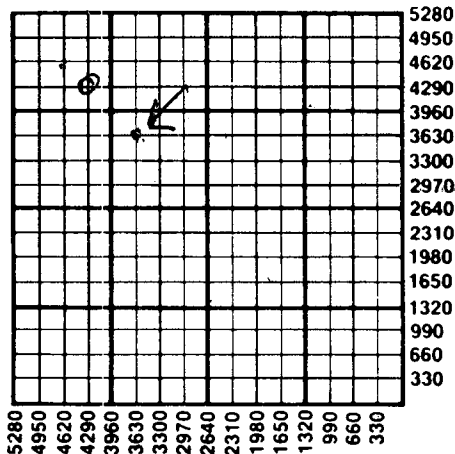

*Rec'd
02-29-1988*

*SM
SM*

State Corporation Commission of Kansas
Conservation Division
200 Colorado Derby Building
Wichita, Kansas 67202-1212
(316) 263-3238