

CARD MUST BE TYPED

State of Kansas NOTICE OF INTENTION TO DRILL

(see rules on reverse side)

CARD MUST BE SIGNED

Starting Date: 5 21 85
month day year

API Number 15- 167-22610-0000

OPERATOR: License # 5146
Name Rains & Williamson Oil Co., Inc.
Address 435 Page Court, 220 West Douglas
City/State/Zip Wichita, Kansas 67202
Contact Person Juanita Green
Phone (316) 265-9686

NE NE SE Sec 34 Twp 11 S, Rge 14 East
(location) West

2310 Ft North from Southeast Corner of Section
330 Ft West from Southeast Corner of Section
(Note: Locate well on Section Plat on reverse side)

CONTRACTOR: License # 5146
Name Same as Above
City/State

Nearest lease or unit boundary line 330 feet.
County Russell
Lease Name JOHN FULLER Well# 2

Well Drilled For: Well Class: Type Equipment:
 Oil Swd Infield Mud Rotary
 Gas Inj Pool Ext. Air Rotary
 OWWO Expl Wildcat Cable

Domestic well within 330 feet: yes no
Municipal well within one mile: yes no

If OWWO: old well info as follows:
Operator,
Well Name,
Comp Date Old Total Depth,
Projected Total Depth 3250 feet
Projected Formation at TD Lansing/Kansas City
Expected Producing Formations Lansing/Kansas City

Depth to Bottom of fresh water 75 feet
Lowest usable water formation Dakota
Depth to Bottom of usable water 525-340 feet
Surface pipe by Alternate: 2 1/2" MC
Surface pipe to be set 290-340 feet
Conductor pipe if any required -0- feet
Ground surface elevation Est. 1720 feet MSL
This Authorization Expires 11-15-85

I certify that we will comply with K.S.A. 55-101, et seq., plus eventually plugging hole to K.C.C. specifications. Talked with Juanita Green 5/15-85. Will set 340' S.P., Alt. 1. 2" MC 5-15-85
Date 5-14-85 Signature of Operator or Agent Wilson Rains Title PRESIDENT

WILSON RAINS


2" MC / WDHE 5-15-85

Must be filed with the K.C.C. five (5) days prior to commencing well
This card void if drilling not started within six (6) months of date received by K.C.C.

RECEIVED
STATE CORPORATION COMMISSION
5-15-85
MAY 15 1985

Important procedures to follow:

A Regular Section of Land
1 Mile = 5,280 Ft.

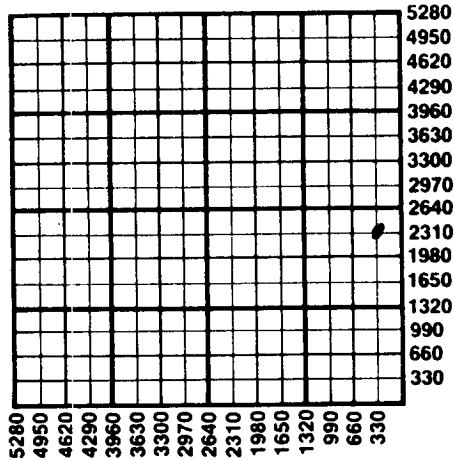

1. Notify District office before setting surface casing.
2. Set surface casing by circulating cement to the top.
3. File completion forms ACO-1 with K.C.C. within 90 days of well completion, following instructions on ACO-1, side 1, and including copies of wireline logs.
4. Notify District office 48 hours prior to old well workover or re-entry.
5. Prior to plugging, prepare a plugging plan, then obtain agreement from the appropriate district office for an approved plugging plan.
6. Submit plugging report (CP-4) to K.C.C. after plugging is completed.
7. Obtain an approved injection docket number before disposing of salt water.
8. Notify K.C.C. within 10 days when injection commences or terminates.
9. If an alternate 2 completion, cement in the production pipe from below any usable water to surface within 120 days of spud date.

CONSERVATION DIVISION
Wichita, Kansas

State Corporation Commission of Kansas
Conservation Division
200 Colorado Derby Building
Wichita, Kansas 67202
(316) 263-3238