

15-199-20020-00-00

STATE OF KANSAS
STATE CORPORATION COMMISSION


Form CP-4

Give All Information Completely
Make Required Affidavit
Mail or Deliver Report to:
Conservation Division
State Corporation Commission
212 No. Market
Wichita, Kansas

WELL PLUGGING RECORD

Wallace County. Sec. 16 Twp. 12S Rge. 42W (E) (W)
Location as "NE/CNW/SW" or footage from lines C-SW-SW
Lease Owner Patrick Petroleum
Lease Name Botkin Well No. 1
Office Address Wichita Kansas
Character of Well (completed as Oil, Gas or Dry Hole) Dry Hole
Date well completed 10-23 1977
Application for plugging filed 10-23 1977
Application for plugging approved 10-23 1977
Plugging commenced 10-24 1977
Plugging completed 10-24 1977
Reason for abandonment of well or producing formation Dry Hole

NORTH

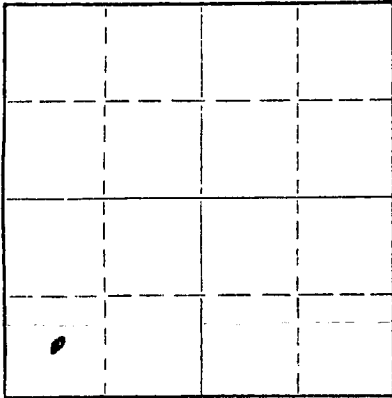

Locate well correctly on above
Section Plat

If a producing well is abandoned, date of last production _____ 19____
Was permission obtained from the Conservation Division or its agents before plugging was commenced? Yes

Name of Conservation Agent who supervised plugging of this well Gilbert Baltazor
Producing formation _____ Depth to top _____ Bottom _____ Total Depth of Well 5380 Feet
Show depth and thickness of all water, oil and gas formations.

OIL, GAS OR WATER RECORDS

CASING RECORD

FORMATION	CONTENT	FROM	TO	SIZE	PUT IN	PULLED OUT
		<u>0</u>	<u>333</u>	<u>8 1/8</u>		

Describe in detail the manner in which the well was plugged, indicating where the mud fluid was placed and the method or methods used in introducing it into the hole. If cement or other plugs were used, state the character of same and depth placed, from _____ feet to _____ feet for each plug set.

70 SKs From 2000 - 1780. 50-52 Pos. 6 to 8 ft.
80 SKs From 1000 - 750. " " "
90 SKs From 300 - 240. " " "
15 SKs From 40 - Surface.
5 SKs Rat hole.

RECEIVED
STATE CORPORATION COMMISSION

DEC 16 1977
12-16-1977
CONSERVATION DIVISION
Wichita, Kansas

(If additional description is necessary, use BACK of this sheet)

Name of Plugging Contractor Jim Snyder Drilling Co
Address Denver Colo.

STATE OF Colorado COUNTY OF Denver, ss.
Ralph Rhodes - Snyder Drilling Co (employee of Snyder Drilling Co) or (owner or operator) of the above-described well, being first duly sworn on oath, says: That I have knowledge of the facts, statements, and matters herein contained and the log of the above-described well as filed and that the same are true and correct. So help me God.

(Signature) Ralph Rhodes

(Address)

SUBSCRIBED AND SWORN to before me this 7th day of December, 1977
Frances E. Kovelchik

My commission expires My Commission expires April 6, 1979

Notary Public.

15-199-20020-00-00

DRILLERS LOG

Company Patrick Petroleum Corporation Contractor: Jim Snyder Drilling Co.
Farm Botkin Elevation: 3963 Gr.
Well No. 1 Casing 8 5/8" @ 341' w/ 225 sx.
Location C SW SW Section 16-12S-42W Production
County Wallace County, Kansas

<u>From</u>	<u>To</u>	<u>Description</u>
0	250	Soil and sand
250	580	Shale
580	624	Chalk
624	1250	Shale and shells
1250	1320	Chalk
1320	1670	Shale and sand
1670	2000	Shale and salt
2000	2600	Sand and shale
2600	3100	Anhydrite and lime and shale
3100	3400	Lime and shale
3400	3550	Shale
3550	4400	Lime and shale
4400	5000	Lime, Shale and chert
5000	5380	Shale, lime, dolomite

RECEIVED
 STATE CORPORATION COMMISSION
 JAN 19 1978
 01-19-1978
 CONSERVATION DIVISION
 Wichita, Kansas

STATE OF COLORADO)
)
 COUNTY OF DENVER)

SS.

I, Ralph Rhodes, of Jim Snyder Drilling Co. upon oath states that the above and foregoing is a true and correct copy from the Daily Drilling Report from your #1 Botkin.

Ralph Rhodes

Subscribed and sworn to before me this 12th day of January, 1978

Francis E. Kowlenchik

 Notary Public

My commission expires: April 6, 1979