


Give All Information Completely  
Make Required Affidavit  
Mail or Deliver Report to:  
Conservation Division  
State Corporation Commission  
211 No. Broadway  
Wichita, Kansas

15-167-03866-0000  
WELL PLUGGING RECORD

NORTH

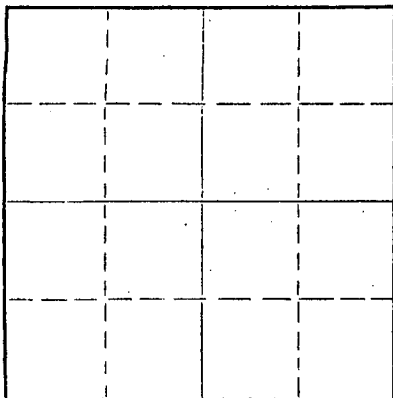

Locate well correctly on above  
Section Plat

Russell County. Sec. 9 Twp. 11S Rge. 15WXX (W)  
Location as "NE/CNW/SW" or footage from lines SW 1/4 SE 1/4 SE 1/4  
Lease Owner Okmar Oil Company  
Lease Name Bowlby Well No. 1  
Office Address 817 Union National Bldg., Wichita, Kansas  
Character of Well (completed as Oil, Gas or Dry Hole) Dry Hole  
Date well completed ~~XXXXXX~~ 11-6-57 19  
Application for plugging filed 11-6-57 19  
Application for plugging approved 11-6-57 19  
Plugging commenced 11-6-57 19  
Plugging completed 11-6-57 19  
Reason for abandonment of well or producing formation Dry Hole

If a producing well is abandoned, date of last production - 19  
Was permission obtained from the Conservation Division or its agents before plugging was commenced? Yes

Name of Conservation Agent who supervised plugging of this well Eldon Petty  
Producing formation \_\_\_\_\_ Depth to top \_\_\_\_\_ Bottom \_\_\_\_\_ Total Depth of Well 3430 Feet  
Show depth and thickness of all water, oil and gas formations.

OIL, GAS OR WATER RECORDS

CASING RECORD

| FORMATION | CONTENT | FROM | TO | SIZE   | PUT IN | PULLED OUT |
|-----------|---------|------|----|--------|--------|------------|
|           |         |      |    | 8 5/8" | 207'   |            |
|           |         |      |    |        |        |            |
|           |         |      |    |        |        |            |
Describe in detail the manner in which the well was plugged, indicating where the mud fluid was placed and the method or methods used in introducing it into the hole. If cement or other plugs were used, state the character of same and depth placed, from \_\_\_\_\_ feet to \_\_\_\_\_ feet for each plug set.

Plugged hole with 20 sacks gel and 80 sacks cement.

11-20-57  
NOV 20 1957  
CONSERVATION DIVISION  
Wichita, Kansas

(If additional description is necessary, use BACK of this sheet)  
Name of Plugging Contractor Leben Drilling, Inc.  
Address 905 Central Bldg. Wichita, Kansas

STATE OF Kansas, COUNTY OF Sedgwick ss.  
James M. Battin (employee of ~~owner~~ or Contractor or ~~operator~~) of the above-described well, being first duly sworn on oath, says: That I have knowledge of the facts, statements, and matters herein contained and the log of the above-described well as filed and that the same are true and correct. So help me God.

(Signature) James M. Battin  
905 Central Bldg., Wichita, Kansas  
(Address)

SUBSCRIBED AND SWORN TO before me this 18th day of November, 19 57

My commission expires June 17, 1961  
Ruth N. Benjamin Notary Public.

PLUGGING  
FILE SEC 9 T 11 R 15W  
BOOK PAGE 61 LINE 6

COMPANY:  
CONTRACTOR:  
FARE:  
LOCATION:

COMMENCED:  
COMPLETED:

OGIAR OIL CO.  
LEBEN DRILLING, INC.  
BOWLEY #1  
SW SE SE SEC. 9-11S-15W  
RUSSELL COUNTY, KANSAS  
10-26-57  
11-6-57

|      |      |                             |           |           |
|------|------|-----------------------------|-----------|-----------|
| 0    | 75   | Sand                        |           |           |
| 75   | 207  | Blue Shale                  | 10231     |           |
| 207  | 500  | Shale                       |           |           |
| 500  | 1005 | Shale & Red Bed             | Anhydrite | 1005      |
| 1005 | 1040 | Anhydrite                   | Topoka    | 2749      |
| 1040 | 1320 | Shale & Shells              | Eschschur | 3002      |
| 1320 | 1625 | Shale                       | Toronto   | 3022      |
| 1625 | 1975 | Shale & Lime                | Lansing   | 3051      |
| 1975 | 2025 | Lime                        | Arbuckle  | 3392      |
| 2025 | 2285 | Lime & Shale                |           |           |
| 2285 | 2800 | Shale & Lime                | Elevation | 1924 K.B. |
| 2800 | 3040 | Lime                        |           |           |
| 3040 | 3240 | Lime                        |           |           |
| 3240 | 3395 | Lime                        |           |           |
| 3395 | 3410 | Lime & Chert (Arb.)         |           |           |
| 3410 | 3430 | Cherty Arbuckle             |           |           |
|      | 3432 | Return Total Depth - P.A.A. |           |           |

Set 207' of 8 5/8" surface casing with 150 sacks cement & 3 sacks CaCl.

I, James Battin, do hereby certify that the above and foregoing is a true and correct copy of the log of the Bowley #1, located SW SE SE of Section 9, Township 11 South, Range 15 West, Russell County, Kansas, as reflected by the files of Leben Drilling, Inc.

LEBEN DRILLING, INC.

By James M. Battin  
James Battin

STATE OF KANSAS )  
                          ) SS  
COUNTY OF SEDGWICK)

Subscribed and sworn to before me, a Notary Public, in and for Sedgwick County, Kansas, this 18th day of November, 1957.

Ruth N. Benjamin  
Ruth N. Benjamin, Notary Public

My commission expires:  
June 17, 1961

STATE OF KANSAS  
STATE CORPORATION COMMISSION

NOV 20 1957  
CONSERVATION DIVISION  
Wichita, Kansas

LOGGING  
SEC. 9 T. 11 R. 15W  
BOOK PAGE 61 LINE 6