

STATE OF KANSAS  
 STATE CORPORATION COMMISSION  
 200 Colorado Derby Building  
 Wichita, Kansas 67202

WELL PLUGGING RECORD  
 K.A.R.-82-3-117

API NUMBER 15-167-01705-0000

LEASE NAME Chrisler B

WELL NUMBER 2

2,310 Ft. from S Section Line

2,970 Ft. from E Section Line

SEC. 9 TWP. 11 RGE. 15 (X) or (W)

COUNTY Russell

Date Well Completed 5/16/63

Plugging Commenced 12/28/89

Plugging Completed 12/28/89

TYPE OR PRINT  
 NOTICE: Fill out completely  
 and return to Cons. Div.  
 office within 30 days.

LEASE OPERATOR BP Exploration

ADDRESS 9401 SW Fwy, Houston, TX 77074

PHONE (713) 272-5000 OPERATORS LICENSE NO. 06854

Character of Well oil

(Oil, Gas, D&A, SWD, Input, Water Supply Well)

The plugging proposal was approved on 12/27/89 (date)

by Dennis Hammel (KCC District Agent's Name).

Is ACO-1 filed? yes If not, Is well log attached? \_\_\_\_\_

Producing Formation L-KC Depth to Top 3,092 Bottom 3,450 T.D. 3,465

PBTD 3346

Show depth and thickness of all water, oil and gas formations.

OIL, GAS OR WATER RECORDS

CASING RECORD

Formation	Content	From	To	Size	Put In	Pulled out
L-KC	Oil (3,092-3,450)	0	101	10-3/4"	101	6'
Arbuckle	Oil (3,450- NDF)	0	3453	7"	3,453	6'

Describe in detail the manner in which the well was plugged, indicating where the mud fluid was placed and the method or methods used in introducing it into the hole. If cement or other plugs were used, state the character of same and depth placed, from feet to feet each set. Set EZSV @ 2,995'. Pumped 100 sx cement w/300# hulls below EZSV. Dumped 10 sx on top of retainer. Spotted 15 sx gel to 1000'. Circulated 135 sx cement from 1000' to surface. Tied onto 7" at surface and pumped 10 sx down csg. Cement was 65/35 poz w/8% gel and 2% CaCl.

(If additional description is necessary, use BACK of this form.)

Name of Plugging Contractor Halliburton License No. 5287

Address 1100 E. 8th, Hays, Kansas

NAME OF PARTY RESPONSIBLE FOR PLUGGING FEES: BP Exploration

STATE OF Texas COUNTY OF Harris, ss.

Scott Marshall


(Employee of Operator) of (Operator) of

above-described well, being first duly sworn on oath, says: That I have knowledge of the facts, statements, and matters herein contained and the log of the above-described well as filed that the same are true and correct, so help me God.

(Signature) Scott Marshall

(Address) 9401 SW Fwy, Houston, TX 77074

RECEIVED  
 STATE CORPORATION COMMISSION  
 1-17-90  
 JAN 17 1990

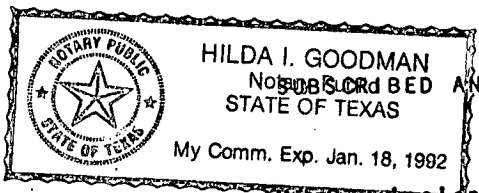

HILDA I. GOODMAN  
 Notary Public  
 STATE OF TEXAS

My Comm. Exp. Jan. 18, 1992

AND SWORN TO before me this 15<sup>th</sup> day of January, 19 90  
Hilda I. Goodman  
 Notary Public

My Commission Expires: 1-18-92

Russell County

CHRISLER B#2

15-167-01705-0000

FAIRPORT

Sec. 9 T11S R15W  
NE-NE-SW

SPUD: 3163

TA'D: 1976

TD: 3465' PBTD: 3346'

10 3/4" @ 101' , 32.75 ppf

100 SX CMT

1 3/4" HOLE

TOC: SURFACE

BLOCK SQUEEZE W/ 400 SX  
TO COVER ANHYDRITE

22-141 50 SHEETS  
22-142 100 SHEETS  
22-144 200 SHEETS



1000'

2000'

3000'

CIBP @ 3346'

ARBUCKLE  
OPEN HOLE  
3453-65'

4000'

RECEIVED  
STATE CORPORATION COMMISSION

NOV 5 1988

CONSERVATION DIVISION  
Wichita, Kansas

LANSING-KANSAS CITY

3092 - 3316'

7" 20 ppf @ 3453'

CMT W/ 150 SX

9 3/4" HOLE

TOC: 2800' (CBL)

ALL EQUIPMENT REMOVED IN 1978.