

PLEASE HOLD THIS INFORMATION CONFIDENTIAL

SIDE ONE

AFFIDAVIT OF COMPLETION FORM

(REV) ACO-1

This form shall be filed in duplicate with the Kansas Corporation Commission, 200 Colorado Derby Building, Wichita, Kansas 67202, within ten days after the completion of the well, regardless of how the well was completed.

Attach separate letter of request if the information is to be held confidential. If confidential, only file one copy. Information on side one will be of public record and side two will then be held confidential.

Circle one: Oil, Gas, Dry, SWD, OWWO, Injection. Type and complete ALL sections. Applications must be filed for dual completion, commingling, SWD and injection.

Attach wireline logs (i.e. electrical log, sonic log, gamma ray neutron log, etc.). KCC # (316) 263-3238. (Rules 82-2-105 & 82-2-125)

OPERATOR Graham-Michaelis Corporation

API NO. 15-167-21,803-0000

ADDRESS P. O. Box 247

COUNTY Russell

Wichita, Kansas 67201

FIELD Bowlby

\*\*CONTACT PERSON Jack L. Yinger

PROD. FORMATION Lansing

PHONE (316) 264-8394

LEASE Elliott

PURCHASER Koch Oil Company

WELL NO. 2 - 7

ADDRESS P. O. Box 2256

WELL LOCATION C S/2 SW NW NW

Wichita, Kansas 67201

1140 Ft. from North Line and

DRILLING Revlin Drilling, Inc.

260 Ft. from West Line of

CONTRACTOR

ADDRESS P. O. Box 88

the NW/4 SEC. 7 TWP. 11S RGE. 15W


Russell, Kansas 67665

WELL PLAT

PLUGGING

CONTRACTOR

ADDRESS

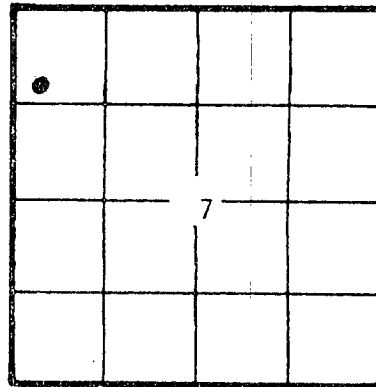

KCC ✓  
KGS ✓  
(Office Use)

TOTAL DEPTH 3510' PBD

SPUD DATE 11/6/81 DATE COMPLETED 12/14/81

ELEV: GR 1880 DF KB 1885

DRILLED WITH (CAXX) (ROTARY) (KXX) TOOLS

Amount of surface pipe set and cemented 260' DV Tool Used? No

A F F I D A V I T

STATE OF Kansas, COUNTY OF Sedgwick SS, I,

Jack L. Yinger OF LAWFUL AGE, BEING FIRST DULY SWORN UPON HIS OATH,

DEPOSES THAT HE IS Vice President (FOR)(OF) Graham-Michaelis Corp.

OPERATOR OF THE Elliott LEASE, AND IS DULY AUTHORIZED TO MAKE

THIS AFFIDAVIT FOR AND ON THE BEHALF OF SAID OPERATOR, THAT WELL NO. 2 - 7 ON

SAID LEASE HAS BEEN COMPLETED AS OF THE 14th DAY OF December, 19 81, AND THAT

ALL INFORMATION ENTERED HEREIN WITH RESPECT TO SAID WELL IS TRUE AND CORRECT.

FURTHER AFFIANT SAITH NOT.

(S) Jack L. Yinger

SUBSCRIBED AND SWORN BEFORE ME THIS 14th DAY OF December, 19 81.

ALDINE M. JOHNSON  
NOTARY PUBLIC  
STATE OF KANSAS  
My Appointment Expires 3-19-85

Aldine M. Johnson  
NOTARY PUBLIC

RECEIVED  
12-16-81  
DEC 16 1981

MY COMMISSION EXPIRES:

\*\*The person who can be reached by phone regarding any questions concerning this information. Within 45 days of completion, a witnessed initial test by the Commission is required if the well produces more than 25 BOPD or is located in a Basic Order Pool.

PLEASE HOLD THIS INFORMATION CONFIDENTIAL