


WELL PLUGGING RECORD

Give All Information Completely  
Make Required Affidavit  
Mail or Deliver Report to:  
Conservation Division  
State Corporation Commission  
800 Bitting Building  
Wichita, Kansas

NORTH

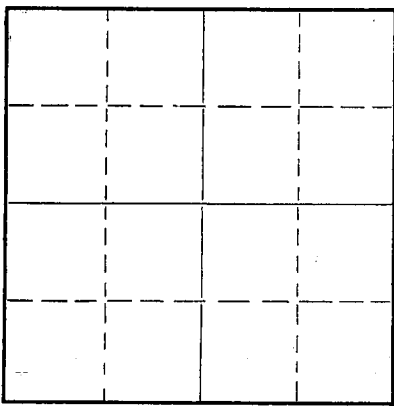

Locate well correctly on above  
Section Plat

Russell County. Sec. 34 Twp. 11s Rge. (E) 15 (W)  
Location as "NE/CNW 1/4 SW 1/4" or footage from lines SE-NE-SE  
Lease Owner The Carter Oil Co.  
Lease Name O.C. Eulert Well No. 1  
Office Address Box 786, Great Bend, Kansas  
Character of Well (completed as Oil, Gas or Dry Hole) Dry Hole  
Date well completed January 5, 19 51  
Application for plugging filed January 5, 19 51  
Application for plugging approved January 5, 19 51  
Plugging commenced January 6, 19 51  
Plugging completed January 6, 19 51  
Reason for abandonment of well or producing formation Dry Hole

If a producing well is abandoned, date of last production None 19  
Was permission obtained from the Conservation Division or its agents before plugging was commenced? Yes

Name of Conservation Agent who supervised plugging of this well Mr. Eldon Petty  
Producing formation Dry hole Depth to top Bottom Total Depth of Well 3310 Feet  
Show depth and thickness of all water, oil and gas formations.


OIL, GAS OR WATER RECORDS

CASING RECORD

Formation	Content	From	To	Size	Put In	Pulled Out
	Dry hole			8 5/8"	173'	None

Describe in detail the manner in which the well was plugged, indicating where the mud fluid was placed and the method or methods used in introducing it into the hole. If cement or other plugs were used, state the character of same and depth placed, from feet to feet for each plug set.

Filled with mud from 3310' to 171'  
8 5/8" wood plug from 171' to 170'  
Reg. Bulk Cement (15 sacks) from 170' to 120'  
Mud from 120' to 35'  
Reg cement (20 sacks) from 35' to Base of cellar.

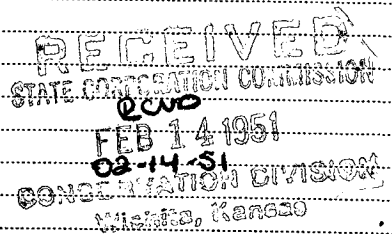

(If additional description is necessary, use BACK of this sheet)

Correspondence regarding this well should be addressed to The Carter Oil Company  
Address Box 786  
Great Bend, Kansas

STATE OF Kansas COUNTY OF Barton, ss.  
W.D. Maxwell

(employee of owner) or (owner or operator) of the above-described well,  
being first duly sworn on oath, says: That I have knowledge of the facts, statements, and matters herein contained and the log of the above-described well as filed and that the same are true and correct. So help me God.


(Signature) W.D. Maxwell Supt.

Box 786, Great Bend, Kansas  
(Address)

SUBSCRIBED AND SWORN to before me this 18 day of January, 19 51

My commission expires July 29, 1950

Notary Public.

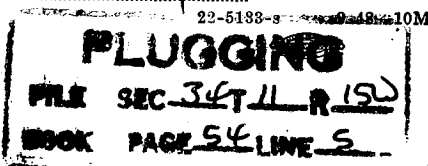

15-167-03873-0000

THE CARTER OIL COMPANY

O. C. EULERT #1  
SE/4 NE/4 SE/4 Sec. 34-11S-15W  
Russell County, Kansas

WELL LOG

Contractor: J. D. Ferrell Drlg. Co., Inc.  
Rotary: 0 - 3310'  
Elevation: 1776'

Great Bend, Kansas  
Date Commenced: 12-20-50  
Date Completed: 1-6-51

Casing Recrod: 173' 8-5/8" 24# casing cemented w/125  
sacks bulk cement by HOWCO

Cellar	5'
Post Rock and Shale	45'
Sand and Shale	130'
Shale and Shells	425'
Sand and Shale	600'
Shale and Shells	840'
Anhydrite	865'
Shale and Shells	1670'
Lime	1840'
Lime and Shale	1925'
Lime	2085'
Lime and Shale	2590'
Lime	2660'
Shale	2672'
Lime	2930'
Shale	2940'
Lime and Shale	3310'
Total Depth	3310'

Geological Tops

Anhydrite . . . . .	840'
Lansing - Ks. City . . .	2938'
Arbuckle . . . . .	3260'
Topeka . . . . .	2632'
Heebner . . . . .	2885'
Dodge . . . . .	2907'
Ks. City . . . . .	2938'
Arbuckle . . . . .	3260'

Production

Dry Hole

Date Commenced

12-30-50

Date Completed

1-6-51

**PLUGGING**  
 FILE SEC 34 T 11 R 15 W  



15-167-03873

# THE CARTER OIL COMPANY

T U L S A 2 , O K L A H O M A

DATE Jan 17, 1951

NAME

SHOW THIS NUMBER ON INVOICE  
No. A-124-B

State of Kansas  
State Corporation Commission Cons. Div.  
800 Bitting Building  
Wichita, Kansas

RENDER ONLY ONE INVOICE  
IN DUPLICATE FOR EACH ORDER  
AND MAIL TO:

THE CARTER OIL CO.  
BOX 801, TULSA 2, OKLA.

SHIP TO - THE CARTER OIL COMPANY  
AT Box 786 Great Bend, Kan

THIS ORDER ACCEPTED BY VENDOR SUBJECT  
TO INSTRUCTIONS AND CONDITIONS ON REVERSE  
SIDE.

CARE OF  
W. D. Maxwell  
F. O. B.

QUANTITY	DESCRIPTION OF MATERIAL OR OTHER SERVICE	PRICE
	<p>CHARGE: AFR 1357 O. C. Eulert #1 - Aband</p> <p>Invoices # - dated 1-10-51</p> <p>For services rendered in plugging above location, SE NE SE 34-11-15W, Russell County - File #54-5</p> <div data-bbox="454 1226 853 1389" style="border: 1px solid black; padding: 5px; margin: 10px 0;"> <p style="text-align: center; font-weight: bold;">PLUGGING</p> <p>FILE SEC 34-11-15W</p> <p>BOOK PAGE 54-5</p> </div> <div data-bbox="925 1349 1316 1624" style="border: 1px solid black; padding: 5px; margin: 10px 0; transform: rotate(-15deg);"> <p style="text-align: center; font-weight: bold; font-size: 1.2em;">RECEIVED</p> <p style="text-align: center;">STATE CORPORATION COMMISSION</p> <p style="text-align: center; font-weight: bold;">JAN 23 1951</p> <p style="text-align: center;">CONSERVATION DIVISION</p> <p style="text-align: center;">WICHITA, KANSAS</p> </div>	25.00

MAIL ALL CORRESPONDENCE  
ON THIS ORDER TO

THE CARTER OIL COMPANY  
MATERIAL AND TRAFFIC DEPARTMENT  
L. E. PATTEN  
TULSA 2, OKLAHOMA

MATERIAL AND/OR SERVICES RECEIVED  
REPRESENTATIVE

### INSTRUCTIONS

1. Advise receipt and acceptance of order promptly, stating when shipment will be made.
2. Show this order number on Tag, Box, Bill of Lading, Express Receipt and Invoice.
3. Transportation charges invoiced must be supported by carrier's original receipted bill.
4. Indicate on your invoice Cash Discount Terms.

### CONDITIONS

#### A. WHERE ORDER COVERS PURCHASE OF MATERIAL:

1. Carter reserves the right to cancel all or any part of this order if not shipped promptly.
2. All material will be subject to our inspection and approval. If rejected, same will be held subject to your instructions, at your risk, and returned, at your expense.
3. No charge for packing and cartage will be allowed unless agreed to in advance.
4. On freight shipments routing specified by Carter shall be used. Otherwise, any extra expense will be charged to shipper. If not otherwise specified, ship via cheapest way.
5. This order must not be filled without authority from Carter at a higher price than last quoted.
6. Carter assumes no responsibility in respect of verbal orders given by employees outside of its Purchasing Department.
7. Seller represents and warrants that applicable provisions of the Fair Labor Standards Act of 1938, as amended, have been complied with in respect to the material listed hereon.
8. Seller warrants that the use or sale by Carter of materials specified herein will not subject it to charges for patent infringement; it further agrees to hold Carter harmless from any and all claims arising from such charges.

#### B. WHERE THIS ORDER COVERS LABOR OR SERVICES TO BE PERFORMED RECIPIENT AGREES AS FOLLOWS:

1. To perform the work specified herein with due diligence according to its own method and at its own risk, it alone having charge and control of all men engaged in carrying out said project, recipient being accountable to Carter only for the completed job.
2. To carry adequate Workmen's Compensation and Liability Insurance, sufficient to protect and save both parties harmless and to furnish Carter satisfactory evidence of compliance herewith prior to the commencement of the work provided for in said order.
3. To furnish Carter full and complete release of all labor and materialmen's claims upon completion of the work provided for in said order upon forms to be furnished by Carter.
4. Not to sublet the work covered hereby without the written consent of Carter.
5. To comply with the applicable provisions of the Fair Labor Standards Act of 1938 in performance of work provided for in said order; to comply with and fully accept both State and Federal Unemployment and Social Security Acts and to furnish its number or numbers given pursuant thereto; to pay all contributions or payroll taxes (State or Federal) as to all employees performing work hereunder; and to otherwise comply with the requirements of said Acts and regulations promulgated pursuant thereto; to furnish Carter Certificate or other evidence of compliance with State and Federal laws covering contributions and payment of taxes on payrolls arising in connection with the performance of work hereunder.