


WELL PLUGGING RECORD

Give All Information Completely
Make Required Affidavit
Mail or Deliver Report to:
Conservation Division
State Corporation Commission
800 Bitting Building
Wichita, Kansas

Russell County, Sec. 35 Twp. 11S Rge. 15W (B) (W)

Location as "NE/CNW $\frac{1}{4}$ /SW $\frac{1}{4}$ " or footage from lines SE NW NE
Lease Owner Anschutz Drilling Company
Lease Name Eulert "B" Well No. 3
Office Address 709 Union Nat'l Bank Bldg., Wichita, Kansas
Character of Well (completed as Oil, Gas or Dry Hole) Dry Hole
Date well completed December 8 1951
Application for plugging filed December 8 1951
Application for plugging approved December 8 1951
Plugging commenced December 8 1951
Plugging completed December 8 1951
Reason for abandonment of well or producing formation

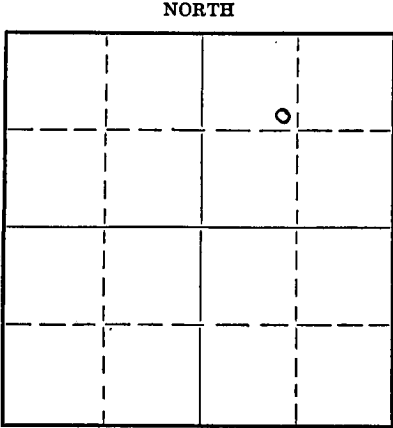

Locate well correctly on above Section Plat

If a producing well is abandoned, date of last production 19
Was permission obtained from the Conservation Division or its agents before plugging was commenced? Yes

Name of Conservation Agent who supervised plugging of this well Eldon Petty
Producing formation Depth to top Bottom Total Depth of Well 3315 Feet
Show depth and thickness of all water, oil and gas formations.

OIL, GAS OR WATER RECORDS

CASING RECORD

| Formation | Content | From | To | Size | Put In | Pulled Out |
|-----------|---------|---------|------|-------|----------|------------|
| | | surface | 162' | 8-5/8 | 11-28-51 | - - |
| | | | | | | |
| | | | | | | |
Describe in detail the manner in which the well was plugged, indicating where the mud fluid was placed and the method or methods used in introducing it into the hole. If cement or other plugs were used, state the character of same and depth placed, from feet to feet for each plug set.

Filled hole with heavy mud. Bottom plug 140', 15 sacks cement
Top Plug 40', 10 sacks cement

Rwo
DEC 10 1951 12-19-51

(If additional description is necessary, use BACK of this sheet)

Correspondence regarding this well should be addressed to
Address Anschutz Drilling Company
709 Union National Bank Bldg., Wichita, Kansas

STATE OF Kansas, COUNTY OF Sedgwick, ss.
H. R. Jensen (employee of owner) or (owner or operator) of the above-described well,
being first duly sworn on oath, says: That I have knowledge of the facts, statements, and matters herein contained and the log of the above-described well as filed and that the same are true and correct. So help me God.

(Signature) H. R. Jensen
709 Union Nat'l Bank Bldg.
(Address)

SUBSCRIBED AND SWORN to before me this 17th day of December, 1951
Wilma V. Shipman
Notary Public.

My commission expires May 24, 1952.

WICHITA DEC 25 1951
BOOK PAGE 131

