


STATE OF KANSAS  
STATE CORPORATION COMMISSION

Form CP-4

WELL PLUGGING RECORD

Give All Information Completely  
Make Required Affidavit  
Mail or Deliver Report to:  
Conservation Division  
State Corporation Commission  
212 No. Market  
Wichita, Kansas 67202

NORTH

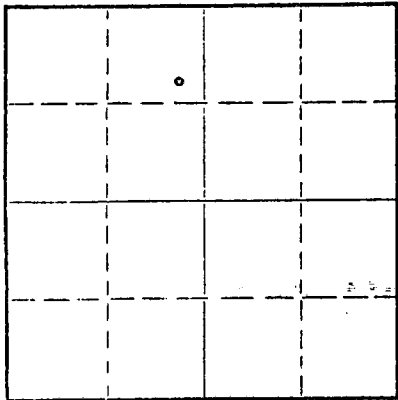

Locate well correctly on above  
Section Flat

Ellis County, Sec. 25 Twp. 11 Rge. 18 (E) 18 (W)  
Location as "NE/CNW/SW" or footage from lines SE NE NW  
Lease Owner Isern-Wells  
Lease Name Marshall Well No. 10  
Office Address Box 486, Ellinwood, Kansas 67526  
Character of Well (completed as Oil, Gas or Dry Hole) oil  
Date well completed \_\_\_\_\_ 19\_\_\_\_  
Application for plugging filed February 11 1970  
Application for plugging approved \_\_\_\_\_ 19\_\_\_\_  
Plugging commenced February 16 1970  
Plugging completed February 20 1970  
Reason for abandonment of well or producing formation depleted

If a producing well is abandoned, date of last production \_\_\_\_\_ 19\_\_\_\_  
Was permission obtained from the Conservation Division or its agents before plugging was commenced? yes

Name of Conservation Agent who supervised plugging of this well Leo Massey  
Producing formation \_\_\_\_\_ Depth to top \_\_\_\_\_ Bottom \_\_\_\_\_ Total Depth of Well 3454 Feet  
Show depth and thickness of all water, oil and gas formations.

OIL, GAS OR WATER RECORDS

CASING RECORD

FORMATION	CONTENT	FROM	TO	SIZE	PUT IN	PULLED OUT
		0	1167'	8 5/8"	1167'	none
		0	3449'	5 1/2"	3449'	2116.79

Describe in detail the manner in which the well was plugged, indicating where the mud fluid was placed and the method or methods used in introducing it into the hole. If cement or other plugs were used, state the character of same and depth placed, from \_\_\_\_\_ feet to \_\_\_\_\_ feet for each plug set.

Sanded back to 3400' and dumped 5 sacks of cement.  
Set 20' rock bridge at 550'. Plugged well with 7 yards of ready mix cement.

RECEIVED  
STATE CORPORATION COMMISSION  
MAR 4 1970  
CONSERVATION DIVISION  
Wichita, Kansas

Name of Plugging Contractor PIPE PULLERS, INC.  
Address Box 486, Ellinwood, Kansas

STATE OF Kansas, COUNTY OF Barton, ss.  
Evelyn Roth (employee of owner) or (owner or operator) of the above-described well, being first duly sworn on oath, says: That I have knowledge of the facts, statements, and matters herein contained and the log of the above-described well as filed and that the same are true and correct. So help me God.

(Signature) Evelyn Roth  
Ellinwood, Kansas  
(Address)

SUBSCRIBED AND SWORN TO before me this 24th day of February, 1970  
George A Meyer  
Notary Public.

My commission expires Feb. 10, 1971

WELL LOG

G. W. KEYES DRILLING COMPANY et al, OWNERS - MARSHALL #10  
SE 1/4 NE 1/4 NW 1/4 Section 25, Township 11, Range 18W  
Ellis County, Kansas

Elevation: 1909 DF

Pipe Record:

8 5/8" set at 1167'  
5 1/2" set at 3149'

Tops corrected 2' to derrick floor

Meebner 3097  
Lansing 3142  
Simpson shale 3123  
Simpson dol 3129  
Arbuckle 3147

Rotary commenced 5-2-49  
completed 5-11-49

Cable tools commenced 5-12-49  
completed 5-15-49

Figures indicate	bottom of formation
0 to	180 shale and shells
	280 sandy shale
	475 shale and shells
	552 sand
	610 lime and shale
	660 sand and pyrite
	825 sand
	847 shale
	860 sand
	875 sand and shale
	1150 red bed, shale and shells
	1157 gypsum
	1190 anhydrite
	1550 shale and shells
	1750 salt, shale and shells
	1980 shale and lime
	2015 sand, lime and shale
	2070 shale and shells
	2295 lime and shale
	2455 sand, lime and shale
	2790 shale and shells
	3139 lime and shale
	3252 lime
	3295 lime and shale
	3399 lime
	3419 cherty conglomerate
	3449 simpson shale
	3454 arbuckle dol.
	3454 Total Depth

RECEIVED  
STATE CORPORATION COMMISSION  
FEB 12 1970  
CONSERVATION DIVISION  
Wichita, Kansas

CABLE TOOL WORK

Moved in cable tools, bailed hole, drilled cement and cleaned out hole to total rotary depth.

STATE OF KANSAS )  
COUNTY OF BARTON ) SS

I, Edw. H. Isern, Part Owner, of the above-described well, being first duly sworn on oath, declare: That I have knowledge of the facts, statements and matters herein contained pertaining to the log of the above-described well, as filed, and that the same are true and correct.

*Edw. H. Isern*

Subscribed and sworn to before me this 18th day of May, 1949.

*George A. Meyer*  
Notary Public

My commission expires Feb. 10, 1951.