

STATE OF KANSAS
STATE CORPORATION COMMISSION

Form CP-4

Give All Information Completely
Make Required Affidavit
Mail or Deliver Report to:
Conservation Division
State Corporation Commission
212 No. Market
Wichita, Kansas

WELL PLUGGING RECORD

Ellis County, Sec. 25 Twp. 11 Rge. 18 ~~XXX~~(W)

Location as "NE/CNW/SW" or footage from lines NE NE NE

Lease Owner Isern-Shultz O&G

Lease Name Marshall Well No. #12

Office Address Box 486 Ellinwood, Ks. 67526

Character of Well (completed as Oil, Gas or Dry Hole) Dry Hole

Date well completed 5-16 19 82

Application for plugging filed 5-16 19 82

Application for plugging approved 5-16 19 82


Plugging commenced 5-16 19 82

Plugging completed 5-16 19 82

Reason for abandonment of well or producing formation

If a producing well is abandoned, date of last production 19

Was permission obtained from the Conservation Division or its agents before plugging was commenced? Yes

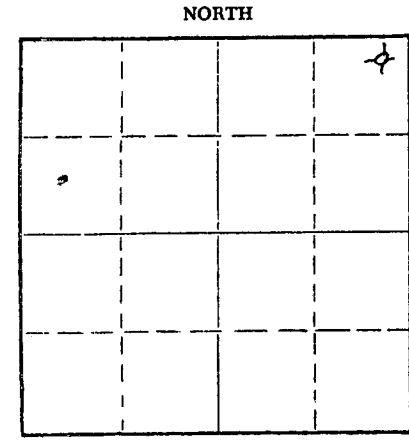

Locate well correctly on above Section Plat

Name of Conservation Agent who supervised plugging of this well Gilbert Scheck

Producing formation Depth to top Bottom Total Depth of Well 3491' Feet

Show depth and thickness of all water, oil and gas formations.

OIL, GAS OR WATER RECORDS

CASING RECORD

| FORMATION | CONTENT | FROM | TO | SIZE | PUT IN | PULLED OUT |
|-----------|---------|------|------|--------|--------|------------|
| Surface | | 0 | 270' | 8 5/8" | 270' | 0 |
| | | | | | | |
| | | | | | | |
| | | | | | | |
| | | | | | | |
| | | | | | | |
| | | | | | | |
| | | | | | | |

Describe in detail the manner in which the well was plugged, indicating where the mud fluid was placed and the method or methods used in introducing it into the hole. If cement or other plugs were used, state the character of same and depth placed, from feet to feet for each plug set.

1st Plug set at 720' with 70 sacks common cement 50-50 Poz 4% Gel 3% Cal Cl

2nd. Plug set at 250' with 40 sacks common cement 50-50 Poz 4% Gel 3% Cal Cl

3rd. Plug set at 40' with 10 sacks common cement 50-50 Poz 4% Gel 3% Cal Cl

10 sacks in rathole

Heavy drilling mud between each plug.

RECEIVED
STATE CORPORATION COMMISSION
MAY 21 1982
05-21-82
CONSERVATION DIVISION
Wichita, Kansas

(If additional description is necessary, use BACK of this sheet)

Name of Plugging Contractor Sun Oilwell Cementing

Address Hays, Ks. 67601

STATE OF Kansas, COUNTY OF Graham, ss.
Jerry M. Helberg (employee of owner) or (owner or operator) of the above-described

well, being first duly sworn on oath, says: That I have knowledge of the facts, statements, and matters herein contained and the log of the above-described well as filed and that the same are true and correct. So help me God.

(Signature) Jerry M. Helberg

(Address)

20th day of May, 1982

March 11, 1986

Coleen A. Waggoner
Coleen A. Waggoner Notary Public.

