


15-051-19305-0000

STATE OF KANSAS  
STATE CORPORATION COMMISSION  
CONSERVATION DIVISION  
P. O. BOX 17027  
WICHITA, KANSAS 67217

FORM CP-4

WELL PLUGGING RECORD

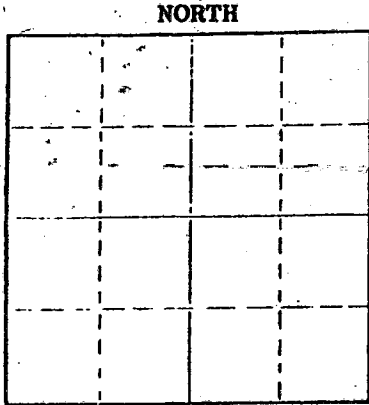

Locate well correctly on above Section Plat

Ellis County, Sec. 18 Twp. 11 Rge. 16 (E) (W) X  
Location as "NE/CNW&SW" or footage from lines SW NE SE  
Lease Owner Okmar Oil Co.  
Lease Name Cress "A" Well No. #2  
Office Address 1130 Vickers KSB&T Bldg. Wichita, Kansas  
Character of Well (completed as Oil, Gas or Dry Hole)  
Date well completed 19  
Application for plugging filed 19  
Application for plugging approved 19  
Plugging commenced 4-1-75 19  
Plugging completed 4-4-75 19  
Reason for abandonment of well or producing formation

If a producing well is abandoned, date of last production 19  
Was permission obtained from the Conservation Division or its agents before plugging was commenced?

Name of Conservation Agent who supervised plugging of this well Leo Massey  
Producing formation Depth to top Bottom Total Depth of Well 3322' Feet  
Show depth and thickness of all water, oil and gas formations.

OIL, GAS OR WATER RECORDS

CASING RECORD

FORMATION	CONTENT	FROM	TO	SIZE	PUT IN	PULLED OUT
				5 1/2"	3322'	1970.67'
				8 5/8"	983'	

Describe in detail the manner in which the well was plugged, indicating where the mud fluid was placed and the method or methods used in introducing it into the hole. If cement or other plugs were used, state the character of same and depth placed, from feet to feet for each plug set.

Made bottom hole plug back with sand to 3275'. Mixed and ran 5 sacks cement thru dump bailer.  
Mudded hole to 310' - set 10' rock bridge. Filled hole with 4 yards ready mix to base of cellar.

RECEIVED  
STATE CORPORATION COMMISSION

Name of Plugging Contractor Southwest Casing Pulling Co. (If additional description is necessary, use BACK of this sheet)  
Address Box 364 Great Bend, Kansas  
CONSERVATION DIVISION  
Wichita, Kansas

STATE OF Kansas COUNTY OF Barton ss.  
Southwest Casing Pulling Co. (employee of owner) or (owner or operator) of the above-described well, being first duly sworn on oath, says: That I have knowledge of the facts, statements, and matters herein contained and the log of the above-described well as filed and that the same are true and correct. So help me God.

(Signature) \_\_\_\_\_  
Box 364 Great Bend, Kansas  
(Address)

Subscribed and Sworn to before me this 5 day of April 1975

Oct. 24, 1976

Sidney D. Miller  
Notary Public.



15-051-19305-0000

DRILLER'S LOG

COMPANY:	Okmar Oil Company
CONTRACTOR:	LEBEN DRILLING, INC.
FARM:	CRESS A-#2
LOCATION:	SW NE SE Sec. 18-11S-16W ELLIS COUNTY, KANSAS
COMMENCED:	10-15-63
COMPLETED:	10-23-63

-----		
0	40	Clay, Sand
40	95	Post Rock
95	350	Shale, Shells
350	485	Sand, Shale
485	973	Redbed & Shale
973	1000	Anhydrite
1000	1705	Shale & Shells
1705	1895	Shale, Lime
1895	2200	Lime & Shale
2200	2435	Shale, Lime
2435	2580	Lime, Shale
2580	2737	Shale & Lime
2737	2835	Lime & Shale
2835	3318	Lime
3318	3324	Sand & Lime
	<u>3374</u>	<u>Rotary Total Depth</u> - Set 5 1/2" Casing

RECEIVED  
 OCT 25 1963  
 COMMISSION

-----

Set 8 5/8" used surface casing @ 983' with landing joint Cemented with 200 sacks Common, 2% c.c. Gel & 225 sacks Sunset.

-----

I, Leslie Kite, do hereby certify that the above and foregoing is a true and correct copy of the log of the Cress A-#2, located in SW NE SE of Section 18, Township 11 South, Range 16 West, Ellis County, Kansas, as reflected by the files of Leben Drilling, Inc.

Leslie Kite  
 Leslie Kite

STATE OF KANSAS )  
 ) SS  
 COUNTY OF BARTON )

Subscribed and sworn to before me, a Notary Public, in and for Barton County, Kansas, this 25th day of October, 1963.

Donald E. Hunt  
 Donald E. Hunt, Notary Public

My Commission Expires:  
 August 17, 1965