

15-051-03286-0000

STATE OF KANSAS
STATE CORPORATION COMMISSION


Give All Information Completely
Make Required Affidavit
Mail or Deliver Report to:
Conservation Division
State Corporation Commission
800 Bittling Building
Wichita, Kansas

WELL PLUGGING RECORD

Ellis County, Sec. 18 Twp. 11S Rge. (E) 16 (W)

Location as "NE/CNW $\frac{1}{4}$ SW $\frac{1}{4}$ " or footage from lines NW, NW, SW
Lease Owner Lario Oil & Gas Company
Lease Name Romine Well No. 3
Office Address 301 S. Market - Wichita, Kansas
Character of Well (completed as Oil, Gas or Dry Hole) Oil
Date well completed November 2, 19 37
Application for plugging filed June 7, 19 56
Application for plugging approved June 8, 19 56
Plugging commenced June 12, 19 56
Plugging completed June 16, 19 56
Reason for abandonment of well or producing formation Depleted
If a producing well is abandoned, date of last production May 28, 19 56
Was permission obtained from the Conservation Division or its agents before plugging was commenced? Yes

NORTH

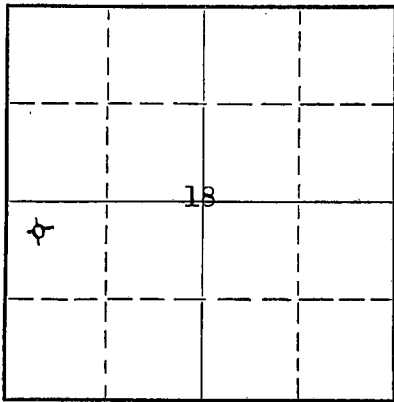

Locate well correctly on above Section Plat

Name of Conservation Agent who supervised plugging of this well Eldon Petty
Producing formation Arbuckle Depth to top 3339 Bottom Total Depth of Well 3347 Feet
Show depth and thickness of all water, oil and gas formations.

OIL, GAS OR WATER RECORDS

CASING RECORD

Formation	Content	From	To	Size	Put In	Pulled Out
				10 3/4"	1025'	None
				7"	3339'	2683'
				Lane Wells plug set at 3115'. Casing perforated at 3092'.		

Describe in detail the manner in which the well was plugged, indicating where the mud fluid was placed and the method or methods used in introducing it into the hole. If cement or other plugs were used, state the character of same and depth placed, from feet to feet for each plug set.

Filled the hole with sand from 3115' to 3092' and ran 4 sacks of cement. Mudded the hole to 300', set a 10' rock bridge and ran 25 sacks of cement. Mudded the hole from 225' to 40', set a 10' rock bridge and ran 10 sacks of cement on top. Plugging completed.

(If additional description is necessary, use BACK of this sheet)

Name of Plugging Contractor West Supply Co., Inc.
Address Chase, Kansas

STATE OF KANSAS, COUNTY OF SEDGWICK, ss.

Leo Ross (employee of owner) or (owner or operator) of the above-described well, being first duly sworn on oath, says: That I have knowledge of the facts, statements, and matters herein contained and the log of the above-described well as filed and that the same are true and correct. So help me God.

(Signature) Leo Ross
301 S. Market, Wichita 2, Kansas
(Address)

SUBSCRIBED AND SWORN to before me this 26th day of June, 19 56



Frances Leslie
Notary Public.
ACW

PLUGGING
FILE SEC. 18 T. 11 R. 16W
BOOK PAGE 69 LINE 19

JUN 27 1956
CONSERVATION DIVISION
Wichita, Kansas

15-051-03286-0000

LARIO OIL & GAS COMPANY
NO. 3 ROMINE

SEC. 18 TWP. 11S RGE. 16W
NW 3W
ELLIS COUNTY, KANSAS

Total Depth - 3347
Commenced - 9-30-37
Completed 11-2-37
Contractor - Broadwater Drilling Co.

Casing

10" 1025'
7" 3339'

(Figures Indicate Bottom of Formations)

sand & shale	40
salc & shells	280
shale	390
shale & shells	420
shale	450
sand	550
lime	590
sand & lime	600
sand	670
shale & shells	900
red rock	1017
lime	1045
lime & red rock	1165
shale & shells	1170
shale & salt	1530
lime & shale	1720
shale	1890
lime	1970
broken lime	2005
lime	2045
shale	2060
broken lime	2230
lime	2245
shale	2275
broken lime	2340
shale & shells	2405
broken lime	2530
shale & shells	2650
shale	2715
lime	2885
shale	2895
lime	2955
lime & shale	2995
broken lime	3070
lime	3280

S.L.M.	3250-3253
shale	3270
lime	3298
shale	3335
Cored	3322 - 3335*
	With 10' Recovery
S.L.M.	3335-3339*
lime	3347
Total Depth	3347
Top Siliceous	3339 Corrected
Potential	- 2173 Bbls. of Oil.

I, George D. Putnam, being first duly sworn on oath, state that I have knowledge of the facts and matter herein presented and that the same are true and correct.

George D. Putnam

Subscribed and sworn before me this 4th day of Nov. 1937.

E. O. Black
Notary Public

My Commission Expires:

April 26, 1941

4-13-56 plugged back to 3115'

PLUGGING
FILE SEC 18 T 11 R 16W
BOOK PAGE 69 LINE 19

RECEIVED
STATE COMMISSION

JUN 1937

CONSTRUCTION