


15-051-03663-0000

WELL PLUGGING RECORD

Give All Information Completely
Make Required Affidavit
Mail or Deliver Report to:
Conservation Division
State Corporation Commission
800 Bitting Building
Wichita, Kansas

Ellis County. Sec. 19 Twp. 11 Rge. 16 (E) W (W)

Location as "NE/CNW $\frac{1}{4}$ SW $\frac{1}{4}$ " or footage from lines NW SE SE
Lease Owner Okmar Oil Company
Lease Name Potter "B" Well No. 1
Office Address 405 Schweiter Building
Character of Well (completed as Oil, Gas or Dry Hole) Oil
Date well completed June 1, 1950 19
Application for plugging filed October 19 19 52
Application for plugging approved October 20 19 52
Plugging commenced October 22 19 52
Plugging completed October 25 19 52
Reason for abandonment of well or producing formation
Never made any oil.
If a producing well is abandoned, date of last production 19
Was permission obtained from the Conservation Division or its agents before plugging was commenced? Yes

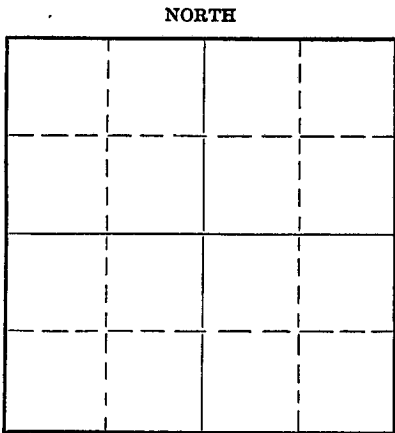

Locate well correctly on above Section Plat

Name of Conservation Agent who supervised plugging of this well Mr. Eldon Petty
Producing formation Depth to top Bottom Total Depth of Well 3385 Feet
Show depth and thickness of all water, oil and gas formations.

OIL, GAS OR WATER RECORDS

CASING RECORD

Formation	Content	From	To	Size	Put In	Pulled Out
				8-5/8	1033'	None
				5-1/2	3376.47'	2636'

Describe in detail the manner in which the well was plugged, indicating where the mud fluid was placed and the method or methods used in introducing it into the hole. If cement or other plugs were used, state the character of same and depth placed, from feet to feet for each plug set.

PLUGGING REPORT

3402 to 3360 ft. Sand
3360 to 3335 ft. 4 sks. cement.
3335 to 240 ft. Mudded.
240 to 230 ft. Rock bridge.
230 to 190 ft. 15 sks. cement.
190 to 30 ft. Mud.
30 ft. to cellar 10 sks. cement.

RECEIVED
STATE CORPORATION COMMISSION

NOV 6 1952

CONSERVATION DIVISION
Wichita, Kansas (If additional description is necessary, use BACK of this sheet)

Correspondence regarding this well should be addressed to Okmar Oil Company
Address 405 Schweiter Building
Wichita, Kansas

STATE OF Kansas, COUNTY OF Sedgwick, ss.
Sheldon K. Beren (employee of owner) or (owner or operator) of the above-described well,
being first duly sworn on oath, says: That I have knowledge of the facts, statements, and matters herein contained and the log of the above-described well as filed and that the same are true and correct. So help me God.


(Signature) Sheldon K Beren

405 Schweiter Building (Address)

SUBSCRIBED AND SWORN to before me this 6th day of November, 19 52

Sept 1, 1956

Urena C. Lane Notary Public.

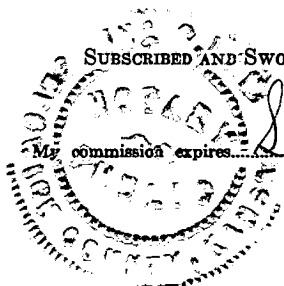

PLUGGING
FILE SEC 19 T 11 R 1624
BOOK PAGE 53 LINE 17

COPY

15-051-03663-0000

PRIME DRILLING COMPANY & BROOKS PIERCE
POTTER WELL NO. 1
Center W/2 SE/4 SE/4, Sec. 19-11S-16W
Ellis County, Kansas

<u>Formations</u>	<u>From</u>	<u>To</u>	<u>Remarks</u>
Shale & post rock	0	45	
Shale & rock	45	90	
Shale & red bed	90	480	
Sand & red bed	480	595	
Iron & sand	595	610	
Sand	610	665	
Shale, shells & red bed	665	1025	
Anhydrite	1025	1065	8-5/8" C.S.A. 1033', cemented
Red bed, shale & shells	1065	1390	w/500 sacks
Salt & shells	1390	1650	
Shale & shells	1650	1755	
Shale & lime	1755	1955	
Lime	1955	2065	
Lime & shale	2065	2150	
Shale & lime	2150	2800	
Lime	2800	3385	5-1/2" C.S.A. 3376.47', cemented
			w/125 sacks
Total Depth:		3385	S.L.M. 3381.47'

I hereby certify the foregoing to be a true and accurate Driller's Log of the formations encountered in the above well.

PRIME DRILLING COMPANY

By /s/ L. J. Kruse
L. J. Kruse, Secretary

Subscribed and sworn to before me this 19th day of July, 1950.

/s/ Hazel Turley
Notary Public

RECEIVED
STATE CORPORATION COMMISSION

My commission expires:
March 13, 1953

NOV - 8 1952

CONSERVATION DIVISION
Wichita, Kansas

PLUGGING
FILE SEC 19 T 11 R 1626
BOOK PAGE 55 LINE 17