

15-051-03746-0000

STATE OF KANSAS
STATE CORPORATION COMMISSION


Form CP-4

WELL PLUGGING RECORD

See All Information Completely
The Required Affidavit
File or Deliver Report to:
Conservation Division
State Corporation Commission
211 No. Broadway
Wichita, Kansas

Ellis County, Sec. 20 Twp. 11S Rge. 16W (X) (W)
Location as "NE/CNW/SW" or footage from lines SW NW NW
Lease Owner Okmar Oil Company
Lease Name Sisters Well No. 2
Office Address 1130 Wichita Plaza, Wichita 2, Kansas
Character of Well (completed as Oil, Gas or Dry Hole) Dry Hole
Date well completed 10-13-63 19
Application for plugging filed 10-13-63 19
Application for plugging approved 10-13-63 19
Plugging commenced 10-13-63 19
Plugging completed 10-13-63 19
Reason for abandonment of well or producing formation Dry Hole

NORTH

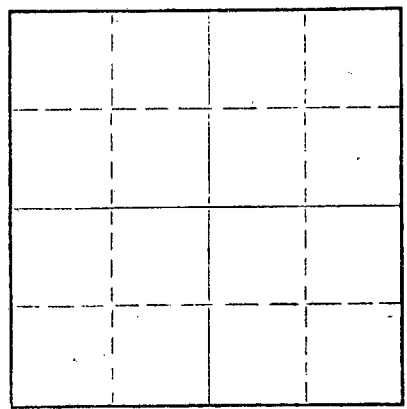

Locate well correctly on above
Section Plat

If a producing well is abandoned, date of last production 19
Was permission obtained from the Conservation Division or its agents before plugging was commenced? yes

Name of Conservation Agent who supervised plugging of this well Eldon Petty, Hays, Kansas
Producing formation _____ Depth to top _____ Bottom _____ Total Depth of Well 3426 Feet
Show depth and thickness of all water, oil and gas formations.

OIL, GAS OR WATER RECORDS CASING RECORD

| FORMATION | CONTENT | FROM | TO | SIZE | PUT IN | PULLED OUT |
|-----------|---------|------|----|--------|--------|------------|
| | | | | 8 5/8" | 189' | none |
| | | | | | | |
| | | | | | | |
| | | | | | | |
| | | | | | | |

Describe in detail the manner in which the well was plugged, indicating where the mud fluid was placed and the method or methods used in introducing it into the hole. If cement or other plugs were used, state the character of same and depth placed, from _____ feet to _____ feet for each plug set.

Plugged hole with 125 sacks 60-40 Posmix

RECEIVED
STATE CORPORATION COMMISSION

OCT 16 1963

CONSERVATION DIVISION
Wichita, Kansas

(If additional description is necessary, use BACK of this sheet)

Name of Plugging Contractor Leben Drilling, Inc.
Address P.O. Box 486, Great Bend, Kansas

STATE OF KANSAS, COUNTY OF BARTON, ss.
Leslie Kite (employee of owner) or (owner or operator) of the above-described

well, being first duly sworn on oath, says: That I have knowledge of the facts, statements, and matters herein contained and the log of the above-described well as filed and that the same are true and correct. So help me God.

(Signature) Leslie Kite

P. O. Box 486, Great Bend, Kansas (Address)

SUBSCRIBED AND SWORN to before me this 15th day of October, 1963

My commission expires April 1, 1967

Ulanda Nichols
Notary Public.



DRILLER'S LOG

COMPANY: Okmar Oil Company
 CONTRACTOR: LEBEN DRILLING, INC.
 FARM: SISTERS #2
 LOCATION: SW NW NW Sec. 20-11S-16W
 ELLIS COUNTY, KANSAS
 COMMENCED: 10-6-63
 COMPLETED: 10-13-63

| | | |
|------|-------------|--|
| 0 | 30 | Clay |
| 30 | 189 | Post Rock & Shale |
| 189 | 265 | Shale & Shells |
| 265 | 500 | Shale & Sand |
| 500 | 530 | Sand |
| 530 | 980 | Shale, Shells, Redbed |
| 980 | 1020 | Redbed & Shale |
| 1020 | 1056 | Anhydrite |
| 1056 | 1495 | Redbed & Shale |
| 1495 | 1730 | Shale with Lime Streaks |
| 1730 | 2300 | Lime & Shale |
| 2300 | 2540 | Shale & Lime |
| 2540 | 2913 | Lime & Shale |
| 2913 | 3383 | Lime |
| 3383 | 3426 | Lime & Chert |
| | <u>3426</u> | <u>Rotary Total Depth - De& A.</u> |

RECEIVED
 OIL CORPORATION COMMISSION
 OCT 16 1963
 CONSERVATION DIVISION
 Wichita, Kansas

Set 8 5/8" used surface casing @ 189' Cemented with 150 sacks Sunset


I, Leslie Kite, do hereby certify that the above and foregoing is a true and correct copy of the log of the Sisters #2, located SW NW NW of Section 20, Township 11 South, Range 16 West, Ellis County, Kansas, as reflected by the files of Leben Drilling, Inc.

Leslie Kite

Leslie Kite

STATE OF KANSAS)
) SS
 COUNTY OF BARTON)

Subscribed and sworn to before me, a Notary Public, in and for Barton County, Kansas, this 15th day of October, 1963.

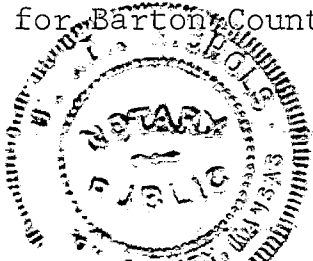

Wanda Nichols

Wanda Nichols, Notary Public

My Commission Expires:
 April 1, 1967