

15-051-20859-0000


STATE OF KANSAS
STATE CORPORATION COMMISSION

Form CP-4

Give All Information Completely
Make Required Affidavit
Mail or Deliver Report to:
Conservation Division
State Corporation Commission
P. O. Box 17027
Wichita, Kansas 67217

WELL PLUGGING RECORD

ELLIS County, Sec. 20 Twplls. Rge. (E) 16 (W)
Location as "NE/CNW&SW" or footage from lines. SW NE NW
Lease Owner Jet Drilling Company, Inc., & Zetco Petroleum, Inc.
Lease Name Sisters of St. Agnes Well No. 2
Office Address 514 One Twenty Bldg., Wichita, Ks. 67202
Character of Well (completed as Oil, Gas or Dry Hole) Dry Hole
Date well completed dry hole Jan. 3, 19 73
Application for plugging filed Jan. 3, 19 73
Application for plugging approved Jan. 3, 19 73
Plugging commenced Jan. 3, 19 73
Plugging completed Jan. 3, (10:45 AM) 19 73
Reason for abandonment of well or producing formation
No Shows - dry hole

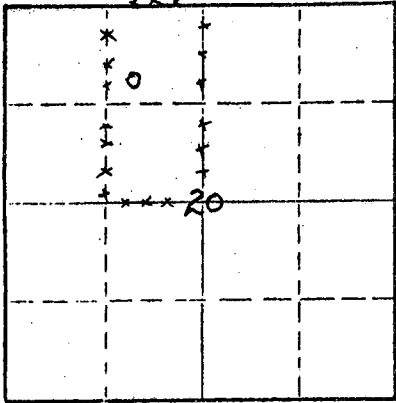

Locate well correctly on above
Section Plat

If a producing well is abandoned, date of last production 19
Was permission obtained from the Conservation Division or its agents before plugging was commenced? Yes

Name of Conservation Agent who supervised plugging of this well Leo Massey, P. O. Box 582, Hays, Kans. 67601
Producing formation Nil Depth to top Bottom Total Depth of Well 3363 Feet
Show depth and thickness of all water, oil and gas formations.

OIL, GAS OR WATER RECORDS

CASING RECORD

FORMATION	CONTENT	FROM	TO	SIZE	PUT IN	PULLED OUT
0' - 15'	soil & Post rock	0	261	8-5/8"	261'	NONE
15' - 45'	Post rock					
45' - 250'	Shale & sand					
250' - 585'	Shale & sand					
585' - 973'	Shale & red Bed					
973' - 988'	Anhydrite					

Describe in detail the manner in which the well was plugged, indicating where the mud fluid was placed and the method or methods used in introducing it into the hole. If cement or other plugs were used, state the character of same and depth placed, from feet to feet for each plug set.

Hole filled with rotary mud from bottom to 500'

50 sack cement plug @ 500' & above

25 sack plug from bottom surface pipe to 240'

10 sack plug 40' to ground level (top of surface pipe)

RECEIVED
STATE CORPORATION COMMISSION
JAN 11 1973
CONSERVATION DIVISION
Wichita, Kansas

(If additional description is necessary, use BACK of this sheet)

Name of Plugging Contractor Allied Cementing Co., Inc.
Address Russell, Kansas 67665 Total 85 sacks cement used.

STATE OF KANSAS, COUNTY OF SEDGWICK, ss.


Arthur M. Scott (employee of owner) or (owner or operator) of the above-described well, being first duly sworn on oath, says: That I have knowledge of the facts, statements, and matters herein contained and the log of the above-described well as filed and that the same are true and correct. So help me God. JET DRILLING COMPANY, INC.

(Signature) Arthur M. Scott

514 One Twenty Bldg., Wichita, Ks. 67202 (Address)

Subscribed and sworn to before me this 10th day of January, 19 73

Carolyn V. Buxton Notary Public.
March 22, 1975

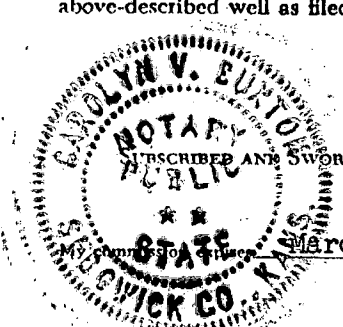

15-051-20859-0000

Operator: Jet Drilling Company, Inc.
514 - 120 Building
Wichita, Kansas 67202
Name: Sisters of St. Agnes #2
Commenced: December 26, 1972
Completed: January 3, 1973
Contractor: Jet Drilling Company, Inc.
514 - 120 Building
Wichita, Kansas 67202
Casing Record: 8-5/8" set @ 261' w/150 sacks,
cement circulated.

Description: SW NE NW
Sec. 20-11S-16W
Ellis County, Kansas
Elevation: 1,792 Gr.
1,787 RKB
Production: Dry Hole D/A

RECEIVED
STATE CORPORATION COMMISSION
JAN 11 1973
CONSERVATION DIVISION
Wichita, Kansas

DRILLER'S LOG

0' - 15' Surface soil & post rock
15' - 45' Post rock
45' - 585' Shale & sand
585' - 973' Shale & red bed
973' - 1,555' Anhydrite
1,555' - 1,895' Shale w/lime streaks
1,895' - 2,985' Lime & shale
2,985' - 3,100' Lime
3,100' - 3,330' K. C. lime
3,330' - 3,363' Conglomerate & Arbuckle
3,363' T. D.

STATE OF KANSAS)
) SS
County of SEDGWICK)

Arthur M. Scott, employee of owner and operator of the above described well, being first duly sworn on oath, says: That I have knowledge of the facts, statements, and matters herein contained and the log of the above described well as filed and that the same are true and correct. So help me God.

Signature Arthur M. Scott
514 One Twenty Bldg., Wichita, Ks.

SUBSCRIBED AND SWORN to before me this 10th day of January, 1973.

My commission expires March 22, 1975

Carolyn V. Buxton
Carolyn V. Buxton, Notary Public

