


STATE OF KANSAS
STATE CORPORATION COMMISSION

Give All Information Completely
Make Required Affidavit
Mail or Deliver Report to:
Conservation Division
State Corporation Commission
P. O. Box 17027
Wichita, Kansas 67217
NORTH

15-051-20918-0000 Form CP-4
WELL PLUGGING RECORD
REC'D OCT 2 1973

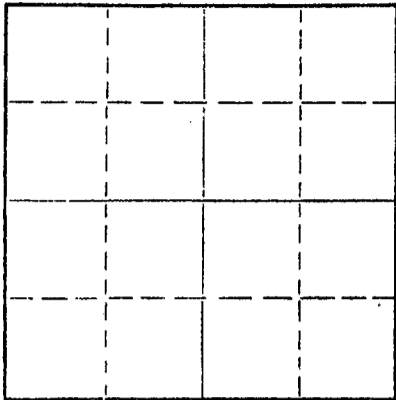

Locate well correctly on above Section Plat

Ellis County, Sec. 20 Twp. 11S Rge. 16W (E) (W) X
Location as "NE/CNW&SW&" or footage from lines SW NW NE
Lease Owner Glen N. Rupe
Lease Name Potter "B" Well No. No. 1
Office Address 925 Olive Garvey Building, Wichita, Kansas 67202
Character of Well (completed as Oil, Gas or Dry Hole) D & A
Date well completed September 26 19 73
Application for plugging filed September 26 19 73
Application for plugging approved September 26 19 73
Plugging commenced September 26 19 73
Plugging completed September 26 19 73
Reason for abandonment of well or producing formation D & A

If a producing well is abandoned, date of last production 19
Was permission obtained from the Conservation Division or its agents before plugging was commenced? Yes

Name of Conservation Agent who supervised plugging of this well Leo F. Massey
Producing formation Depth to top Bottom Total Depth of Well 3325 Feet
Show depth and thickness of all water, oil and gas formations.

OIL, GAS OR WATER RECORDS

CASING RECORD

FORMATION	CONTENT	FROM	TO	SIZE	PUT IN	PULLED OUT
				8-5/8"	653'	-0-

Describe in detail the manner in which the well was plugged, indicating where the mud fluid was placed and the method or methods used in introducing it into the hole. If cement or other plugs were used, state the character of same and depth placed, from feet to feet for each plug set.

Plugged @ 650' w/50 sx 50-50 pozmix
Plugged @ 300' w/25 sx
Plugged - bridge to hold kelly @ 40' w/10 sx


RECEIVED
STATE CORPORATION COMMISSION
OCT 3 1973
CONSERVATION DIVISION
Wichita, Kansas

(If additional description is necessary, use BACK of this sheet)
Name of Plugging Contractor Red Tiger Drilling Company
Address 1720 Wichita Plaza, Wichita, Kansas 67202

STATE OF Kansas COUNTY OF Sedgwick, ss.
Linda H. Dickens (employee of owner) or (owner or operator) of the above-described well, being first duly sworn on oath, says: That I have knowledge of the facts, statements, and matters herein contained and the log of the above-described well as filed and that the same are true and correct. So help me God.

(Signature) Linda H. Dickens
1720 Wichita Plaza, Wichita, Kansas 67202
(Address)

SUBSCRIBED AND SWORN TO before me this 1st day of October, 19 73

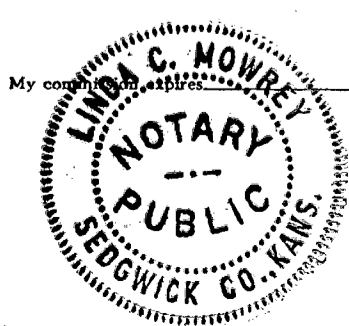

My commission expires May 24, 1977

Linda C. Mowrey
Notary Public.

15-051-20918-0000

DRILLERS LOG

No. 1 Potter "B"

CASING RECORD:

8-5/8" @ 653'
w/250 sx cement

TOTAL DEPTH: 3325'

COMPANY: Glen H. Rupe

CONTRACTOR: Red Tiger Drilling Co.

COMMENCED: September 17, 1973

COMPLETED: September 26, 1973

DESCRIPTION:

SW NW NE
20-11S-16W
Ellis County,
Kansas

ELEVATION:


<u>FORMATION</u>	<u>FROM</u>	<u>TO</u>	<u>REMARKS</u>
Clay & Sand	0	55	
Rock & Shale	55	285	
Shale	285	380	
Shale, Sand	380	470	
Pyrite & Sand	470	530	
Sand	530	590	
Shale	590	653	
Shale & Redbed	653	770	
Redbed	770	946	
Anhydrite	946	979	
Shale & Shells	979	994	
Redbed & Shale	994	1555	
Shale & Lime	1555	2750	
Lime	2750	2829	
Shale & Lime	2829	2980	
Lime	2980	3325	

RECEIVED
STATE CORPORATION COMMISSION
OCT 3 1973
CONSERVATION DIVISION
Wichita, Kansas

I certify that this is a true and correct copy of the above log to the best of my knowledge.

RED TIGER DRILLING COMPANY

Linda H. Dickens
Linda H. Dickens

Subscribed and sworn to before me this 1st day of October, 1973.

Linda C. Mowrey
Notary Public

My Commission Expires:

May 24, 1977

