

15-167-21266-00-00

STATE OF KANSAS
STATE CORPORATION COMMISSION

WELL PLUGGING RECORD

Give All Information Completely
Make Required Affidavit
Mail or Deliver Report to
Conservation Division
State Corporation Comm.
245 North Water
Wichita, KS 67202

Russell County, Sec. 7 Twp. 13S Rge. 13 E/W
Location as "NE/CNW $\frac{1}{4}$ SW $\frac{1}{4}$ " or footage from lines
NW NW NE

Lease Owner Rains & Williamson Oil Co., Inc.

Lease Name Holland Well No. #3

Office Address 435 Page Court, 220 W. Douglas, Wichita, Ks.

Character of Well (Completed as Oil, Gas or Dry Hole)
Dry Hole

Date Well completed 6-1-79 19

Application for plugging filed 6-1-79 19

Application for plugging approved 6-1-79 19

Plugging commenced 6-1-79 19

Plugging completed 6-1-79 19

Reason for abandonment of well or producing formation

Commercial quantities of oil not found


If a producing well is abandoned, date of last production
19

Was permission obtained from the Conservation Division or
its agents before plugging was commenced? Yes

Name of Conservation Agent who supervised plugging of this well Duane Rankin, Great Bend, Ks.

Producing formation _____ Depth to top _____ Bottom _____ Total Depth of Well 3315'

Show depth and thickness of all water, oil and gas formations.

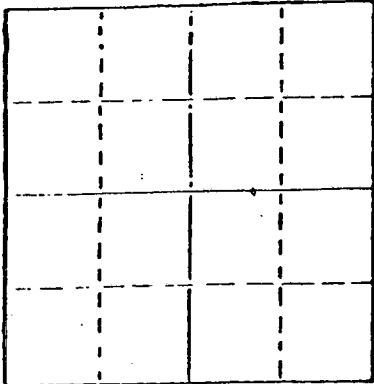

Locate well correctly on above
Section Plat

OIL, GAS OR WATER RECORDS

CASING RECORD

| FORMATION | CONTENT | FROM | TO | SIZE | PUT IN | PULLED OUT |
|-----------|---------|------|----|--------|--------|------------|
| | | | | 8 5/8" | 244' | None |
| | | | | | | |
| | | | | | | |
| | | | | | | |

Describe in detail the manner in which the well was plugged, indicating where the mud fluid
was placed and the method or methods used in introducing it into the hold. If cement or other
plugs were used, state the character of same and depth placed, from _____ feet to
_____ feet for each plug set.

- Plug @ 450' w/50 sx.
- Plug @ 240' w/25 sx.
- Plug @ 40' w/10 sx.
- Rat Hole 2 sx.

RECEIVED
STATE CORPORATION COMMISSION

JUN - 8 1979
06-08-1979

(If additional description is necessary, use BACK OF THIS REPORT)
Name of Plugging Contractor Buffalo Drilling Company, Inc. Wichita, Kansas


STATE OF Kansas COUNTY OF Sedgwick, ss.
Wilson Rains of Buffalo Drilling Company, Inc. (employee of owner) or (owner or operator
of the above-described well, being first duly sworn on oath, says: That I have knowledge of
the facts, statements, and matters herein contained and the log of the above described well
as filed and that the same are true and correct. So help me God.

(Signature) Wilson Rains
435 Page Court, 220 W. Douglas, Wichita, Kansas 67202
(Address)

SUBSCRIBED AND SWORN TO before me this 5 day of June, 1979

Juanita M. Green
Juanita M. Green Notary Public.

My commission expires

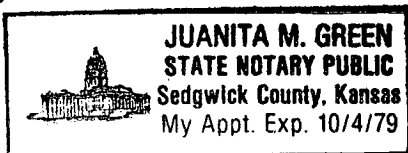

DRILLER'S LOG

COMPANY: Rains & Williamson Oil Co., Inc.

SEC. 7 T.13S R. 13W

WELL NAME: Holland #3

LOC. NW NW NE

RIG NO. #7

COUNTY: Russell

TOTAL DEPTH 3315'

ELEVATION 1793 GL 1798 KB

COMMENCED: 5-23-79

COMPLETED: 6-1-79

CONTRACTOR: Buffalo Drilling Company, Inc.

CASING RECORD:

SURFACE: 8 5/8" @ 244' w/165 sx. 60/40 poz., 2% gel, 3% cc.

PRODUCTION: D&A

LOG

(Figures Indicate Bottom of Formations)

| | |
|---------------------------|-------------|
| Lime | 810 |
| Shale | 870 |
| Shale & Shells | 1667 |
| Shale | 1975 |
| Shale, Lime & Shells | 2196 |
| Shale & Lime | 2420 |
| Shale | 2643 |
| Lime | 3315 |
| <u>ROTARY TOTAL DEPTH</u> | <u>3315</u> |

RECEIVED
STATE CORPORATION COMMISSION

JUN - 8 1979
06-08-1979
CONSERVATION DIVISION
Wichita, Kansas

STATE OF Kansas)

COUNTY OF Sedgwick)

SS:

I, Wilson Rains of Buffalo Drilling Company, Inc.

upon oath state that the above and foregoing is a true and correct copy of the log of the
Holland #3 well.

Wilson Rains
Wilson Rains

Subscribed and sworn to before me this 5 day of June, 1979.

My Appointment Expires
JUANITA M. GREEN
STATE NOTARY PUBLIC
Sedgwick County, Kansas
My Appt. Exp. 10/4/79

Juanita M. Green
Juanita M. Green