

15-167-03881-00-00

STATE OF KANSAS  
STATE CORPORATION COMMISSION

WELL PLUGGING RECORD

OR

FORMATION PLUGGING RECORD

Strike out upper line  
when reporting plug-  
ging off formations.

Give All Information Completely  
Make Required Affidavit  
Mail or Deliver Report to:  
Conservation Division  
State Corporation Commission  
800 Bitting Building  
Wichita, Kansas

Russell County, Sec. 30 Twp. 13 Rge. 12 (E) W. (W)

Location as "NE 1/4 NW 1/4 SW 1/4" or footage from lines 280 ft from W. line 330 ft from S line

Lease Owner H & M Drilling Co.

Lease Name Cora E Shaffer Well No. 1

Office Address Leon, Kansas

Character of Well (completed as Oil, Gas or Dry Hole) dry hole

Date, well completed April 23rd 19 41

Application for plugging filed April 25th 19 41

Application for plugging approved April 25th 19 41

Plugging Commenced April 25th 19 41

Plugging Completed April 26th 19 41

Reason for abandonment of well or producing formation Dry hole

If a producing well is abandoned, date of last production 19

Was permission obtained from the Conservation Division or its agents before plugging was commenced? yes

Name of Conservation Agent who supervised plugging of this well C.T. Alexander, Great Bend, Kansas

Producing formation Depth to top Bottom Total Depth of Well 3360 Feet

Show depth and thickness of all water, oil and gas formations.

OIL, GAS OR WATER RECORDS

CASING RECORD

Formation	Content	From	To	Size	Put In	Pulled Out
sand	water	340	345	12 1/2"	470	470
sand	water	450	455	10"	764	764
lime	water	2622	2645	8"	2424	2424
lime	water	3319	3326	6"	2989	2989
				5 3/16"	3326	3326

Describe in detail the manner in which the well was plugged, indicating where the mud fluid was placed and the method or methods used in introducing it into the hole. If cement or other plugs were used, state the character of same and depth placed, from feet to feet for each plug set.

Mudded from 3360 to 3340

cement " 3340 to 3329

mudded " 3329 to 2989

Cement " 2989 to 2974


mudded " 2974 to 250

Cement " 250 to 235

Mudded " 235 to 15

Cement " 15 to 8

Cellar filled

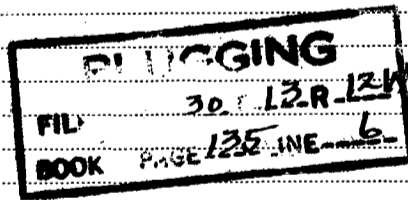

(If additional description is necessary, use BACK of this sheet)

Correspondence regarding this well should be addressed to H & M Drilling Co.



Address Leon, Kansas

STATE OF Kansas, COUNTY OF Butler, ss.

(employee of owner) or (owner or operator) of the above-described well, being first duly sworn on oath, says: That I have knowledge of the facts, statements, and matters herein contained and the log of the above-described well as filed and that the same are true and correct. So help me God.

(Signature) E. G. Hammer

Leon, Kansas (Address)

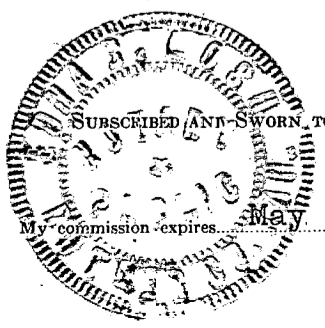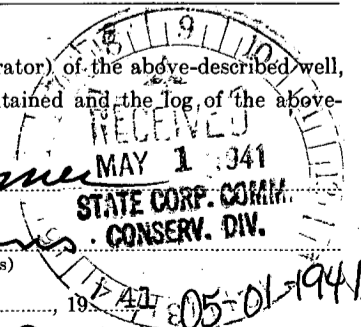

19 41

Edna B Bosh

Notary Public.

Drilled 280 feet from West line, 330 feet from south line SW of SE of Section 30-township 13-range 12W- Russell county, Kansas

Drilling Contractors: H & M Drilling Co. Leon, Kansas. Drilling commenced March 14th 1941. Drilling completed April 23rd 1941. Completed as dry hole.

Soil	8	Shale	2365
Lime	10	Shale and shells	2380
Clay	30	Shale	2420
Shale	45	Lime	2421
Shale and shell	60	shale	2460
Shale	105	Lime	2465
Lime	110	Shale	2476
Shale	230	Lime	2512
red rock	245	Shale	2520
Shale	260	shale and Lime	2530
Red Rock	285	Lime	2545
Lime	290	shale	2558
shale	295	Lime	2564
Red Rock	340	Lime and shale	2570
sand ( 6 B.W. )	345	shale and shell	2575
shale	400	Shale	2622
Lime	403	Lime ( 1 B.W. )	2645
Shale	450	Shale	2650
Sand (10 B.W.)	455	Lime (Top of Topeka)	2682
Shale	470	shale	2690
red Rock	768	Lime	2700
Anhydrite	795	Shale and shell	2717
Lime	800	Lime	2878
red Rock	970	Shale	2 780
Shale	1000	Lime	2795
Red Rock	1050	Shale	2800
shale	1140	Lime	2826
Lime ( 1/4 B.W. )	1160	Shale	2831
Salt	1432	Lime	2918
Shale	1437	Shale	2935
Salt	1460	Lime - Dodge	2952
shale and shell	1475	red Rock	2955
Lime	1500	Lime (Top of K,C.SLM)	2989
Shale	1505	Shale	3007
Lime	1535	Lime	3080
Shale	1540	Shale	3083
Lime	1560	Lime (2 B.W.)	3107
Shale	1605	Red Rock	3130
Lime	1625	Lime	3135
Shale	1650	Shale	3138
Lime	1670	Lime	3140
Shale	1705	shale (Show of oil)	3145
Lime	1735	3152 to 3159	
Shale	1740	Lime	3175
Lime	1780	Lime	3193
Lime-Broken	1785	Shale	3198
Lime	1830	Lime	3207
shale	1845	shale	3210
Red Rock	1855	Shale and shells	3214
Lime	1875	Lime (Show of oil 3214	32 37
Shale	1880	Shale to 3218, & Shell	3245
Lime (1/4 B.W.)	1910	Lime	3263
Shale	1925	Shale	3267
Lime	1943	Lime	3273
Shale	1947	Var. Col. Shale	3280
Lime	1975	Shale and shell	3295
shale and shell	1980	Gravel	3304
Shale	1990	Shale and lime	3310
Lime	2000	Lime	3315
Red Rock	2060	Red Rock	3319
Lime	2080	Lime-hole full water	3326
Shale	2085	sand	3330
Lime	2115	Shale	3332
Shale	2125	Gorham sand-water	3337
Lime	2150	Granit wash	3352
Shale	2155	Siliceous Lime	3360
Lime	2180		
Shale	2220		
Lime	2290		
Lime and shale	2343	Total depth	3360

**DRILLING**  
 FILE 301 12-R124  
 BOOK PAGE 135 LINE-6

Pipe Record

12 1/2" Casing	470	ft
10 " "	764	"
8 " "	2424	"
6 " "	2989	"
5 3/16 " "	3326	"

05-01-1941