


STATE OF KANSAS
STATE CORPORATION COMMISSION

WELL PLUGGING RECORD

Give All Information Completely
Make Required Affidavit
Mail or Deliver Report to
Conservation Division
State Corporation Comm.
245 North Water
Wichita, KS 67202

Barber County. Sec. 35 Twp. 32S Rge. 10W E/W
Location as "NE/CNW 1/4 SW 1/4" or footage from lines
NE SW

Lease Owner George R. Jones
Lease Name Lawrence Well No. 3
Office Address 125 N. Market, Suite 1210, Wichita, Kansas 67202
Character of Well (Completed as Oil, Gas or Dry Hole) Dry Hole

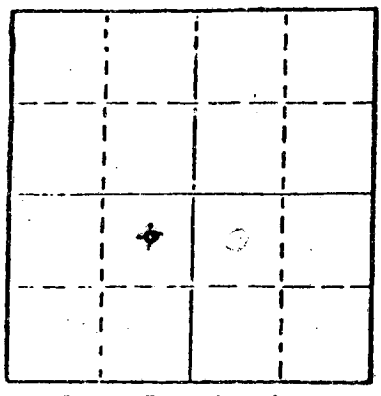

Locate well correctly on above Section Plat

Date Well completed Dec. 31, 1981
Application for plugging filed Dec. 31, 1981
Application for plugging approved Dec. 31, 1981
Plugging commenced Dec. 31, 1981
Plugging completed Dec. 31, 1981
Reason for abandonment of well or producing formation Dry Hole

If a producing well is abandoned, date of last production 19

Was permission obtained from the Conservation Division or its agents before plugging was commenced? Yes

Name of Conservation Agent who supervised plugging of this well Morris Lesley
Producing formation _____ Depth to top _____ Bottom _____ Total Depth of Well _____
Show depth and thickness of all water, oil and gas formations.

OIL, GAS OR WATER RECORDS

CASING RECORD

FORMATION	CONTENT	FROM	TO	SIZE	PUT IN	PULLED OUT

Describe in detail the manner in which the well was plugged, indicating where the mud fluid was placed and the method or methods used in introducing it into the hold. If cement or other plugs were used, state the character of same and depth placed, from _____ feet to _____ feet for each plug set.

- 125 sks Class H, 2% Gel, 3% CC,
- 60 sks @ 650'
- 40 sks @ 360'
- 10 sks @ 40' -0
- 10 sks RH
- 5 sks MH

(If additional description is necessary, use BACK of this sheet)

Name of Plugging Contractor Halliburton

STATE OF Kansas COUNTY OF Sedgwick, ss.
Jerome D. Marcus (employee of owner) or (owner or operator)

of the above-described well, being first duly sworn on oath, says: That I have knowledge of the facts, statements, and matters herein contained and the log of the above-described well as filed and that the same are true and correct. So help me God

(Signature) Jerome D. Marcus
401 E. Douglas, Suite 402, Wichita, Kansas 67202
(Address)

SUBSCRIBED AND SWORN TO before me this 5th day of January, 19 82

My commission expires June 8, 1985



Cheryl L. Benoit
Notary Public.

RECEIVED
STATE CORPORATION COMMISSION

JAN - 7 1982 RWD
01-07-82
CONSERVATION DIVISION
Wichita Kansas