

STATE OF KANSAS  
STATE CORPORATION COMMISSION

WELL PLUGGING RECORD

Give All Information Completely  
Make Required Affidavit  
Mail or Deliver Report to  
Conservation Division  
State Corporation Comm.  
245 North Water  
Wichita, KS 67202

BARBER County. Sec. 35 Twp. 32S Rge. 10  W  
Location as "NE/CNW $\frac{1}{4}$ /SW $\frac{1}{4}$ " or footage from lines C SW SW

Lease Owner George R. Jones  
Lease Name Lawrence Well No. 1

Office Address Suite 1310, 125 No. Mkt., Wichita, Ks 67202  
Character of Well (Completed as Oil, Gas or Dry Hole)

dry hole


Date Well completed April 6, 1979 19  
Application for plugging filed April 1, 1979 19  
Application for plugging approved April 10, 1979 19  
Plugging commenced April 6, 1979 19  
Plugging completed April 6, 1979 19

Reason for abandonment of well or producing formation  
dry hole

If a producing well is abandoned, date of last production 19

Was permission obtained from the Conservation Division or its agents before plugging was commenced? yes

Name of Conservation Agent who supervised plugging of this well William T. Owen  
Producing formation Mississippian Depth to top -- Bottom -- Total Depth of Well 4425'  
Show depth and thickness of all water, oil and gas formations.

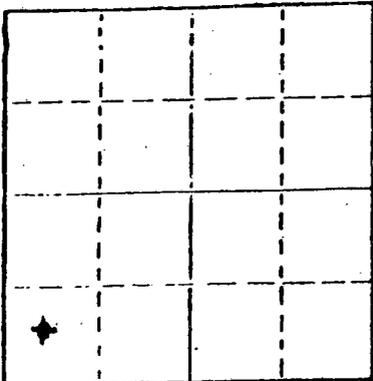

Locate well correctly on above Section Plat

OIL, GAS OR WATER RECORDS

CASING RECORD

FORMATION	CONTENT	FROM	TO	SIZE	PUT IN	PULLED OUT
		Ran 9 jts	20#	8-5/8" csg set at 359'		
		cemented with 275		sx common 3% CC		
		PD 4:45 p.m.	3/30/79			

Describe in detail the manner in which the well was plugged, indicating where the mud fluid was placed and the method or methods used in introducing it into the hold. If cement or other plugs were used, state the character of same and depth placed, from feet to feet for each plug set.

Plug #1 @ 330' w/40 sx  
Plug and bridge @ 40' w/12 sx  
rathole 3 sx  
D & A @ 3:00 p.m. 4/6/79

RECEIVED  
STATE CORPORATION COMMISSION

APR 17 1979

CONSERVATION DIVISION  
Wichita, Kansas

(If additional description is necessary, use BACK) Name of Plugging Contractor GABBERT-JONES, Inc.

STATE OF KANSAS COUNTY OF SEDGWICK, ss.  
(employee of owner) or (owner or operator)  
of the above-described well, being first duly sworn on oath, says: That I have knowledge of the facts, statements, and matters herein contained and the log of the above-described well as filed and that the same are true and correct. So help me God.

(Signature) George R. Jones  
George R. Jones, Suite 1310, 125 No. Market  
(Address) Wichita, Kansas 67202

SUBSCRIBED AND SWORN TO before me this 16th day of April, 1979

Wilma E. Clark  
Wilma E. Clark Notary Public.

My commission expires August 5, 1980

