


STATE OF KANSAS
STATE CORPORATION COMMISSION

WELL PLUGGING RECORD

Give All Information Completely
Make Required Affidavit
Mail or Deliver Report to:
Conservation Division
State Corporation Commission
P. O. Box 17087
Wichita, Kansas 67217
NORTH

Ellis County, Sec. 31 Twp. 11 Rge. 20 (E) (W)

Location in "NE/CNW/SW" or footage from lines C W/2 NW NW
Lease Owner Clinton Oil Company
Lease Name John Huck A#4 Well No. _____
Office Address Wichita, Kansas 67202
Character of Well (completed as Oil, Gas or Dry Hole) Oil
Date well completed 11-18- 19 56
Application for plugging filed 10-30 19 73
Application for plugging approved 11-1 19 73
Plugging commenced 11/1/73 19
Plugging completed 11/2/73 19
Reason for abandonment of well or producing formation depleted
If a producing well is abandoned, date of last production June 19 67
Was permission obtained from the Conservation Division or its agents before plugging was commenced? yes

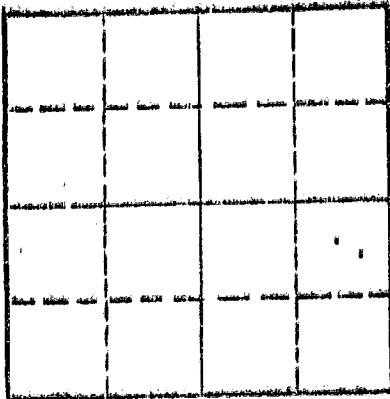

Locate well correctly on above Section Plot

Name of Conservation Agent who supervised plugging of this well Massey
Producing formation Arbuckle Depth to top 3864' Bottom 3901' Total Depth of Well 3950'
Show depth and thickness of all water, oil and gas formations.

OIL, GAS OR WATER RECORDS

CASING RECORD

FORMATION	CONTENT	FROM	TO	SIZE	PUT IN	PULLED OUT
				8-5/8	208	none
				5 1/2	3938	686'

Describe in detail the manner in which the well was plugged, indicating where the mud fluid was placed and the method or methods used in introducing it into the hole. If cement or other plugs were used, state the character of same and depth placed, from _____ feet to _____ feet for each plug set.

Checked hole, ran sand to 3850' and dumped 5 sacks cement.
Set 30' bridge and dumped 3 sacks cement. Loaded hole, shot pipe at 690' and pulled 21 joints. Bailed fluid to 200' and set 10' rock bridge and dumped 3 yards ready mix.

PLUGGING COMPLETE.

RECEIVED
STATE CORPORATION COMMISSION
NOV 20 1973
CONSERVATION DIVISION
Wichita, Kansas

(If additional description is necessary, use BACK of this sheet)
Name of Plugging Contractor KELSO CASING PULLING
Address CHASE, KANSAS


STATE OF KANSAS, COUNTY OF RICE
R. DARRELL KELSO (employee of owner) or (owner or operator) of the above-described well, being first duly sworn on oath, says: That I have knowledge of the facts, statements, and matters herein contained and the log of the above-described well as filed and that the same are true and correct. No help me God.

(Signature) R. Darrell Kelso
CHASE, KANSAS
(Address)

Subscribed and sworn to before me this 5th day of November, 19 73

Margaret Melcher
Notary Public.

My commission expires

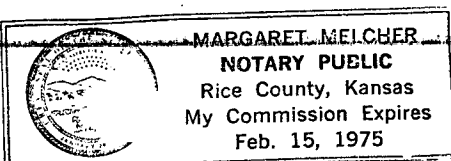

FORMATION RECORD

DESCRIBE EACH FORMATION DRILLED. INDICATE THICKNESS, CONTENT AND WHETHER DRY, OR OIL, GAS, OR WATER BEARING.

FORMATION	TOP	BOTTOM	FORMATION	TOP	BOTTOM
Sand and shale	0	209			
Shale and shells	209	1170			
Sand	1170	1410			
Shale	1410	1455			
Shale and shells	1455	1674			
Anhydrite	1674	1725			
Shale and shells	1725	1990			
Shale and shells	1990	2085			
Shale and lime	2085	2180			
Lime	2180	2185			
Shale and lime streaks	2185	2225			
Shale and shells	2225	2280			
Shale and lime	2280	2295			
Lime and shale streaks	2295	2305			
Shale and lime	2305	3375			
Lime	3375	3440			
Lime and shale breaks	3440	3490			
Lime	3490	3830			
Lime and shale	3830	3846			
Lime	3846	3872			
Lime and chert	3872	3882			
Lime	3882	3940			
TOTAL DEPTH	3940				
COMMENCED OPERATIONS:	10-17-56				
DATE SPUDDED:	10-18-56				
DATE COMPLETED:	11-18-56				
3824-51'					
DST #1/TOOL OPEN ONE HR REC 9' MUD. NS. IBHP 0. FBHP 0.. SIBHP 0 20 MIN.					
DST #2 3828-69' MISRUN. TOOL PLUGGED.					
DST #3 3825-69' TOOL OPEN ONE HR REC 27' MUD. NS. IBHP 315#, FBHP 0#, SIBHP 230 IN 20 MIN.					
DST #4 3868-82' TOOL OPEN ONE HR REC 130' HOOM. IBHP 305#, IFBHP 70#, FFBHP 105#, SIBHP 225# IN 30 MIN.					
PERF 3894-96' X 3899-3901' X 8 SHOTS PER FOOT.					
PACKER SET AT 3885' ACD THROUGH PERF 3894-96', 3899-3901' X 500 GAL 15% RETARDED ACD.					

RECEIVED
 NOV 1 1956
 GEORGE COFFMAN
 CATCHER