


STATE OF KANSAS
STATE CORPORATION COMMISSION

Give All Information Completely
Make Required Affidavit
Mail or Deliver Report to:
Conservation Division
State Corporation Commission
211 No. Broadway
Wichita, Kansas

WELL PLUGGING RECORD

Ellis County, Sec. 31 Twp. 11S Rge. (E) 20 (W)

Location as "NE/CNW/SW" or footage from lines NE/4 SW/4 NE/4
Lease Owner Skelly Oil Company
Lease Name J. L. Caskey Well No. 7
Office Address Box 1650, Tulsa, Oklahoma
Character of Well (completed as Oil, Gas or Dry Hole) Dry Hole
Date well completed May 16, 19 56
Application for plugging filed May 16, 19 56
Application for plugging approved May 17, 19 56
Plugging commenced May 16, 19 56
Plugging completed May 16, 19 56
Reason for abandonment of well or producing formation Dry Hole

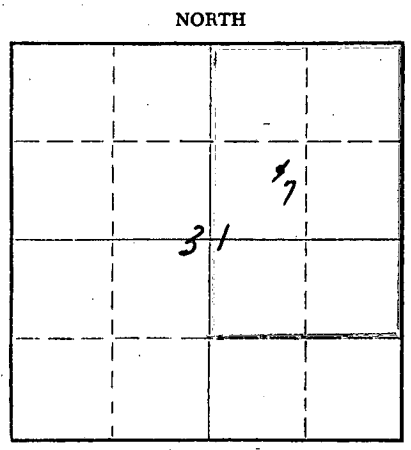

Locate well correctly on above Section Plat

If a producing well is abandoned, date of last production _____ 19____
Was permission obtained from the Conservation Division or its agents before plugging was commenced? Yes (verbally)

Name of Conservation Agent who supervised plugging of this well Mr. Eldon Petty
Producing formation _____ Depth to top _____ Bottom _____ Total Depth of Well 3952 Feet
Show depth and thickness of all water, oil and gas formations.

OIL, GAS OR WATER RECORDS

CASING RECORD

FORMATION	CONTENT	FROM	TO	OD SIZE	PUT IN	PULLED OUT
Arbuckle Lime	Dry	3938'	3952'	8-5/8"	270' 0"	None

Describe in detail the manner in which the well was plugged, indicating where the mud fluid was placed and the method or methods used in introducing it into the hole. If cement or other plugs were used, state the character of same and depth placed, from _____ feet to _____ feet for each plug set.

25 sacks of cement	3952' to 3870'
Mud laden fluid	3870' to 277'
25 sacks of cement	277' to 202'
Mud laden fluid	202' to 70'
25 sacks of cement	70' to 6'
Surface soil	6' to 0'


RECEIVED
STATE CORPORATION COMMISSION
MAY 24 1956
CONSERVATION DIVISION
Wichita, Kansas

(If additional description is necessary, use BACK of this sheet)
Name of Plugging Contractor Claude Wentworth Drilling Co., Inc.
Address 2701 East 15th Street, Tulsa, Oklahoma

STATE OF Kansas, COUNTY OF Reno, ss.
H. E. Wamsley (employee of owner) ~~operator~~ of the above-described well, being first duly sworn on oath, says: That I have knowledge of the facts, statements, and matters herein contained and the log of the above described well as filed and that the same are true and correct. So help me God.

(Signature) _____
Box 391, Hutchinson, Kansas
(Address)

SUBSCRIBED AND SWORN TO before me this 22nd day of May, 19 56
My commission expires April 7, 1959
Josephine L. Johnson Notary Public.

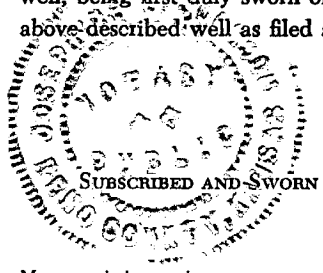

PLUGGING
FILE SEC 31 T 11 R 20W
BOOK PAGE 62 LINE 8