


STATE OF KANSAS
STATE CORPORATION COMMISSION

WELL PLUGGING RECORD

Give All Information Completely
Make Required Affidavit
Mail or Deliver Report to:
Conservation Division
State Corporation Commission
800 Biting Building
Wichita, Kansas

Ellis County. Sec. 31 Twp. 11S Rge. 20 (W)
Location as "NE/CNW&SW&" or footage from lines SW/4 NE/4 SW/4
Lease Owner Stanolind Oil and Gas Company
Lease Name John Huck "B" Well No. 2
Office Address Box 1654 Oklahoma City, Okla.
Character of Well (completed as Oil, Gas or Dry Hole) Dry Hole
Date well completed April 17, 1956
Application for plugging filed Verbal April 17, 1956
Application for plugging approved Verbal April 17, 1956
Plugging commenced April 17, 1956
Plugging completed April 17, 1956
Reason for abandonment of well or producing formation Dry hole

NORTH R20W

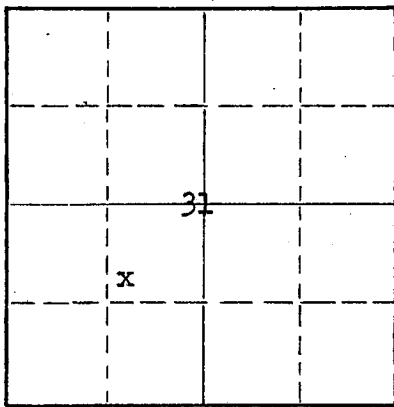

T
11
S

Locate well correctly on above
Section Plat

If a producing well is abandoned, date of last production 19
Was permission obtained from the Conservation Division or its agents before plugging was commenced? Yes

Name of Conservation Agent who supervised plugging of this well Mr. Eldon Petty
Producing formation None Depth to top Bottom Total Depth of Well 3968 Feet
Show depth and thickness of all water, oil and gas formations.

OIL, GAS OR WATER RECORDS

CASING RECORD

FORMATION	CONTENT	FROM	TO	SIZE	PUT IN	PULLED OUT
Heebner	Water	3524		8-5/8"	228'	None
Lansing	Water	3561				
Arbuckle	Water	3868				

Describe in detail the manner in which the well was plugged, indicating where the mud fluid was placed and the method or methods used in introducing it into the hole. If cement or other plugs were used, state the character of same and depth placed, from feet to feet for each plug set.

Total Depth 3968'. Mud from 3968' to 220'. Set plug at 220', capped with 1/2 sack hulls and 15 sacks cement. Mud to 40'. Set plug and capped with 1/2 sack hulls and 10 sacks cement to bottom of cellar.


(If additional description is necessary, use BACK of this sheet)

Name of Plugging Contractor Transit Corporation
Address 1516 Liberty Bank Bldg., Oklahoma City, Okla.

STATE OF Kansas, COUNTY OF Ellis, ss.
Ralph Ludwick (employee of owner) of the above-described well, being first duly sworn on oath, says: That I have knowledge of the facts, statements, and matters herein contained and the log of the above-described well as filed and that the same are true and correct. So help me God.

(Signature) Ralph Ludwick Field Supt.
Drawer 389 Hays, Kansas (Address)

SUBSCRIBED AND SWORN TO before me this 19th day of April, 1956.
My commission expires April 27, 1959
Ludwick
Notary Public.

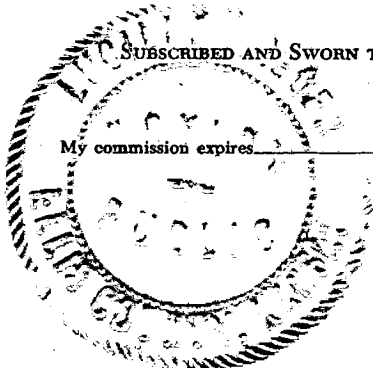

PLUGGING
FILE SEC 31 T 11 R 20W
BOOK PAGE 55 LINE 19

RECEIVED
STATE CORP COM
APR 20 1956
CONSERVATION DIVISION
Wichita, Kansas

FORMATION RECORD

DESCRIBE EACH FORMATION DRILLED. INDICATE THICKNESS, CONTENT AND WHETHER DRY, OR OIL, GAS, OR WATER BEARING.

FORMATION	TOP	BOTTOM	FORMATION	TOP	BOTTOM
Surface Clay	0	35			
Shale and Sand	35	175			
Shale and Shells	175	233			
Shale	233	435			
Shale and Shells	435	750			
Sand and Shale	750	1150			
Sand	1150	1450			
Shale	1450	1690			
Anhydrite	1690	1745			
Shale and Shells	1745	2230			
Shale and Lime Shells	2230	2370			
Shale and Lime	2370	2510			
Shale and Shells	2510	3270			
Sand	3270	3280			
Shale and Shells	3280	3335			
Lime and Shale	3335	3859			
Lime	3859	3869			
Lime and Shale	3869	3883			
Lime	3883	3968			
TOTAL DEPTH	3968				
Operations Commenced:	4-2-56				
Date Spudded:	4-2-56				
Date Completed:	4-17-56				
<p>4-16-56 TD 3968'. WOO. DST #1 3873-81'. TOOL OPEN ONE HR CLOSED 20 MIN. REC 7' MUD X SPECKS OF OIL. NO PRESSURES. RELOG. TOOK DST #2 3855-97'. TOOL OPEN ONE HR CLOSED 20 MIN. REC 10' MUD X SPECKS OF OIL. INITIAL FLOW PRESS ZERO. FINAL FLOW PRESS ZERO. MIPSI 90%. T AND 3868' (-1601').</p>					
<p>4-18-56 TD 3968'. COMP AS TRY HOLE 4-17-56. RIB ELEV 2267'. PIA 4-17-56.</p>					