


15-179-20311-00-00

STATE OF KANSAS
STATE CORPORATION COMMISSION

Form CP-4

Give All Information Completely
Make Required Affidavit
Mail or Deliver Report to:
Conservation Division
State Corporation Commission
P. O. Box 17027
Wichita, Kansas 67217
NORTH

WELL PLUGGING RECORD

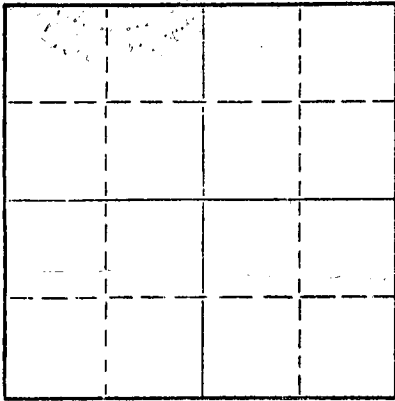

Locate well correctly on above
Section Plat

Sheridan County, Sec. 13 Twp. 10 Rge. 26 (E) W (W)
Location as "NE/CNWxSWx" or footage from lines SE SW NW
Lease Owner Dreiling Oil, Inc.
Lease Name Gano Well No. 2
Office Address Victoria, KS 67671
Character of Well (completed as Oil, Gas or Dry Hole) Dry Hole
Date well completed 6-11 19 72
Application for plugging filed 6-11 19 72
Application for plugging approved 6-11 19 72
Plugging commenced 6-11 19 72
Plugging completed 6-11 19 72
Reason for abandonment of well or producing formation Dry Hole

If a producing well is abandoned, date of last production 19
Was permission obtained from the Conservation Division or its agents before plugging was commenced? Yes

Name of Conservation Agent who supervised plugging of this well Leo Massey Hays, Kansas 67601
Producing formation Depth to top Bottom Total Depth of Well Feet
Show depth and thickness of all water, oil and gas formations.


OIL, GAS OR WATER RECORDS

CASING RECORD

FORMATION	CONTENT	FROM	TO	SIZE	PUT IN	PULLED OUT
Surface Pipe				8 5/8	253'	

Describe in detail the manner in which the well was plugged, indicating where the mud fluid was placed and the method or methods used in introducing it into the hole. If cement or other plugs were used, state the character of same and depth placed, from feet to feet for each plug set.

1st plug was set at 1300' with 110 cu. ft. cement
2nd plug was set at 275' with 30 cu. ft. cement
3rd plug was set at 40' with 10 cu. ft. cement

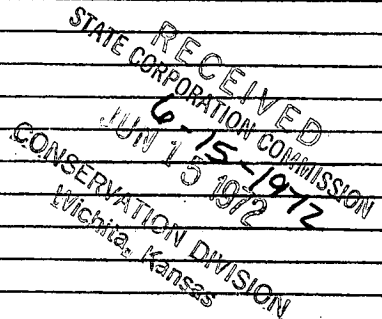


(If additional description is necessary, use BACK of this sheet)

Name of Plugging Contractor Dreiling Oil, Inc.
Address Victoria, Kansas 67671

STATE OF Kansas, COUNTY OF Ellis, ss.
I, Joe Hess, Sec. Treas. of Drlg. Contr. (employee or owner or owner or operator) of the above-described well, being first duly sworn on oath, says: That I have knowledge of the facts, statements, and matters herein contained and the log of the above-described well as filed and that the same are true and correct. So help me God.

(Signature) [Signature]
JOE HESS, Victoria, KS 67671
(Address)

SUBSCRIBED AND SWORN to before me this 13th day of June, 1972

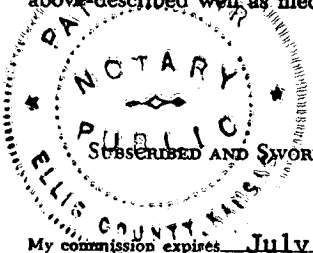

[Signature] PATTY ROHR
Notary Public.

