


STATE OF KANSAS
STATE CORPORATION COMMISSION

Give All Information Completely
Make Required Affidavit
Mail or Deliver Report to:
Conservation Division
State Corporation Commission
211 No. Broadway
Wichita, Kansas

R

WELL PLUGGING RECORD

NORTH

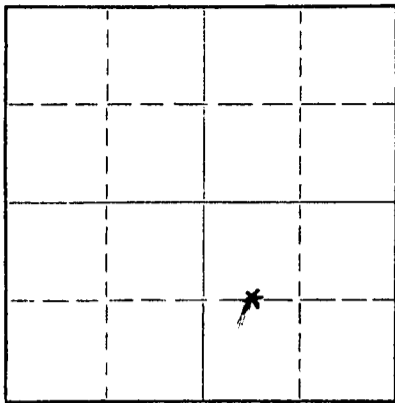

Locate well correctly on above
Section Plat

Morton County. Sec. 3 Twp. 35 Rge. 13 (E) (W)
Location as "NE/CNW/SE" or footage from lines 1320' N/S + 660' E/W of SE/4
Lease Owner Panhandle Eastern Pipe Line Company
Lease Name Leewe Well No. 2-3
Office Address Box 979, Liberal, Kansas
Character of Well (completed as Oil, Gas or Dry Hole) Dry Hole
Date well completed 4-22 1960
Application for plugging filed 5-5 1960
Application for plugging approved 5-6 1960
Plugging commenced 5-11 1960
Plugging completed 5-12 1960
Reason for abandonment of well or producing formation Dry Hole

If a producing well is abandoned, date of last production _____ 19____
Was permission obtained from the Conservation Division or its agents before plugging was commenced? Yes

Name of Conservation Agent who supervised plugging of this well W. L. Lackamp
Producing formation _____ Depth to top _____ Bottom _____ Total Depth of Well 3000 Feet
Show depth and thickness of all water, oil and gas formations.

OIL, GAS OR WATER RECORDS

CASING RECORD

FORMATION	CONTENT	FROM	TO	SIZE	PUT IN	PULLED OUT
				8 5/8"	580	None
				4 1/2"	3000	1497

Describe in detail the manner in which the well was plugged, indicating where the mud fluid was placed and the method or methods used in introducing it into the hole. If cement or other plugs were used, state the character of same and depth placed, from _____ feet to _____ feet for each plug set.

Filled hole with heavy mud to 640 feet. Spotted 20 sacks cement, filled to 30 feet of surface, spotted 10 sacks cement to top. Cut off casing 5 feet below ground level.

RECEIVED
STATE CORPORATION COMMISSION
JUN 2 1960
CONSERVATION DIVISION
Wichita, Kansas

(If additional description is necessary, use BACK of this sheet)

Name of Plugging Contractor Daco Lease and Well Service
Address 1700 South Main, Borger, Texas

STATE OF Kansas, COUNTY OF Seward, ss.
Panhandle Eastern Pipe Line Company (employee of owner) or (owner or operator) of the above-described well, being first duly sworn on oath, says: That I have knowledge of the facts, statements, and matters herein contained and the log of the above-described well as filed and that the same are true and correct. So help me God.

(Signature) R. L. Shields Manager
Drilling and Production
Box 979, Liberal, Kansas (Address)

SUBSCRIBED AND SWORN TO before me this 26th day of May, 1960

My Commission Expires
December 8, 1963

Satiria Jackson
Notary Public.

My commission expires _____



DRILLER'S LOG

WELL NAME: Leewe 2-3; COMPANY OPERATING: Panhandle Eastern Pipe Line Co:
 ADDRESS of COMPANY: Box 351, Liberal, Kansas:

WELL LOCATION: C 1/4 W/2 1/4 SE 1/4,
1320 ft. North of South line,
2970 ft. East of West line; Sec. 3, Twp. 35S, Rge. 113W, Morton County, Kansas

DRILLING STARTED 3-30, 1960; DRILLING COMPLETED 4-8, 1960
 WELL COMPLETED 4-22, 1960; WELL CONNECTED _____, 19____

ELEVATION: _____ ft. Ground Level; CHARACTER OF WELL (Oil, Gas, or Dry Hole) Dry

OIL OR GAS SANDS OR ZONES - PERFORATIONS - ACIDIZING AND FRACTURING INFORMATION					
Name	From	To	No. of Shots	Gallons Used	Kind Used
				6000	15%
				500	MCA
				2147	15% with 3000 lbs. Sand

CASING RECORD

Size	Amount Set	Sacks of Cement	Amount Pulled
8 5/8"	580	300	None
4 1/2"	3000	140	None

FORMATION RECORD

Formation	Top	Bottom	Formation	Top	Bottom
Sand and Clay	0	220			
Sand	220	310			
Red Bed	310	645			
Lime	645	785			
Red Bed	785	1155			
Red Bed and Sand	1155	1440			
Shale	1440	1825			
Shale and Lime	1825	2261			
Lime and Shale	2261	2533			
Lime	2533	2575			
Lime and Shale	2575	3000			
Total Depth	3000				

RECEIVED
 STATE CORPORATION COMMISSION
 MAY 24 1960
 CONSERVATION DIVISION
 Wichita, Kansas

RESULTS of INITIAL PRODUCTION TEST: _____