


STATE OF KANSAS  
STATE CORPORATION COMMISSION

Give All Information Completely  
Make Required Affidavit  
Mail or Deliver Report to:  
Conservation Division  
State Corporation Commission  
800 Bitting Building  
Wichita, Kansas

OR  
FORMATION PLUGGING RECORD

Strike out upper line  
when reporting plug-  
ging off formations.

NORTH

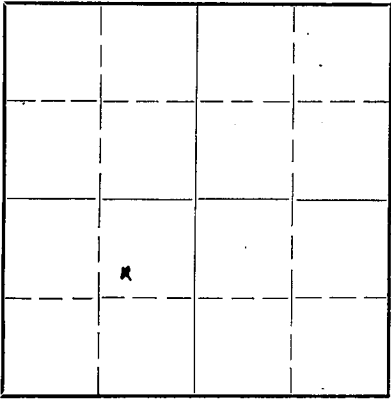

Locate well correctly on above  
Section Plat

Lincoln County, Sec 36 Twp. 13 Rge. (E) 7.(W)  
Location as "NE 1/4 NW 1/4 SW 1/4" or footage from lines SW NE SW  
Lease Owner Bird-Hanley & Sheedy  
Lease Name V. E. Paull Well No. 1  
Office Address 407 Kaufman Building, Wichita 2, Kansas  
Character of Well (completed as Oil, Gas or Dry Hole) Dry Hole  
Date well completed September 3 19 43  
Application for plugging filed September 3 19 43  
Application for plugging approved September 3 19 43  
Plugging commenced September 3 19 43  
Plugging completed September 4 19 43  
Reason for abandonment of well or producing formation D & A

If a producing well is abandoned, date of last production 19  
Was permission obtained from the Conservation Division or its agents before plugging was commenced? Yes

Name of Conservation Agent who supervised plugging of this well Ruel Durkee  
Producing formation Depth to top Bottom Total Depth of Well 4103 Feet  
Show depth and thickness of all water, oil and gas formations.


OIL, GAS OR WATER RECORDS

CASING RECORD

Formation	Content	From	To	Size	Put In	Pulled Out
				surface casing @ 311'	cemented	

Describe in detail the manner in which the well was plugged, indicating where the mud fluid was placed and the method or methods used in introducing it into the hold. If cement or other plugs were used, state the character of same and depth placed, from feet to feet for each plug set.

Filled hole to 300' of top, ran plug to bottom of surface pipe @ 311', cemented 15 sacks on top of plug, filled mud to 10' from top, set plug and cotton hulls on top of mud, cemented 5 sacks at bottom of cellar.

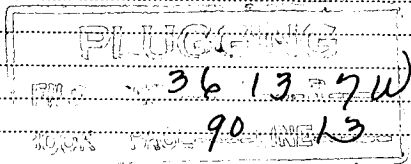

(If additional description is necessary, use BACK of this sheet)


Correspondence regarding this well should be addressed to Bird-Hanley & Sheedy  
Address 407 Kaufman Building, Wichita 2, Kansas

STATE OF KANSAS, COUNTY OF SEDGWICK, ss.  
C. L. Sheedy (employee of owner) or (owner or operator) of the above-described well,  
being first duly sworn on oath, says: That I have knowledge of the facts, statements, and matters herein contained and the log of the above-described well as filed and that the same are true and correct. So help me God.

(Signature) C. L. Sheedy  
407 Kaufman Bldg., Wichita 2, Kans.  
(Address)

SUBSCRIBED AND SWORN to before me this 23 day of November

My commission expires July 15, 1946

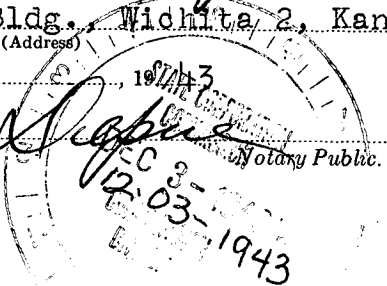

V. E. Paull #1  
 SWC NE/4 SW/4 Section 36-13N-7W  
 Lincoln County, Kansas  
 Bird, Hanley & Sheedy

Commenced: August 10, 1943  
 Completed: September 3, 1943

Surface rock and clay	0	90	Sandy lime	2630	2640
Sand	90	105	Lime	2640	2680
Shale and shells	105	200	Broken lime and little sand	2680	2704
Sand	200	215	Broken lime	2704	2711
Shale	215	235	Lime	2711	2730
Red bed	235	300	Lime, broken	2730	2775
Shale and Lime streaks	300	320	Sandy lime	2775	2800
Sand	320	375	Lime	2800	2845
Dakota Sand	375	400	Lime, shale streaks	2845	2890
Shale	400	435	Sandy lime	2890	2902
Sandy shale	435	465	Lime	2902	2940
Sand	465	540	Lime, sandy	2940	2948
Blue shale	540	560	K. C. lime	2948	3169
Red bed	560	605	Lime	3169	3335
Shale, various shades	605	800	Shale	3335	3380
Shale and salt	800	1112	Lime and shale	3380	3412
Broken lime	1112	1145	Shale, lime streaks	3412	3451
Lime	1145	1180	Shale	3451	3469
Sandy lime, shale streaks	1180	1305	Mississippi lime	3469	3527
Lime	1305	1450	Shale	3527	3545
Lime and shale	1450	1540	Lime	3545	3560
Lime, hard	1540	1550	Shale	3560	3595
Lime, quartz and pyrite	1550	1595	Sand	3595	3600
Lime	1595	1715	Shale	3600	3656
Red rock	1715	1727	Sandy shale	3656	3661
Lime	1727	1780	Chert	3661	3667
Shale	1780	1810	Shale	3667	3679
Lime, shale streaks	1810	1875	Viola lime	3679	3749
Broken lime	1875	1937	Lime	3749	3755
Sandy shale	1937	1970	Shale	3755	3849
Shale and shells	1970	2015	Viola lime	3849	3945
Shale, shells, lime streaks	2015	2065	Lime	3945	4000
Sandy shale	2065	2148	Shale	4000	4058
Lime and shale	2148	2175	Lime	4058	4103
Broken lime	2175	2285			
Conglomerate	2285	2290	TOTAL DEPTH	4103	
Broken lime	2290	2305			
Lime, broken	2305	2362	Casing Record:		
Shale	2362	2382	10 3/4" casing set at 309' and cemented		
Lime	2382	2428	with 200 sacks cement		
Shale	2428	2462			
Topeka lime	2462	2538			
Lime	2538	2565			
Topeka lime	2565	2630			



**PLUGGING**  
 FILE SEC-36-T/3-R7W  
 BOOK PAGE 90 LINE 13

V. E. Paull #1  
 SWC NE/4 SW/4 Section 36-13N-7W  
 Lincoln County, Kansas  
 Bird, Hanley & Sheedy

Commenced: August 10, 1943  
 Completed: September 3, 1943

Surface rock and clay	0	90	Sandy lime	2630	2640
Sand	90	105	Lime	2640	2680
Shale and shells	105	200	Broken lime and little sand	2680	2704
Sand	200	215	Broken lime	2704	2711
Shale	215	235	Lime	2711	2730
Red bed	235	300	Lime, broken	2730	2775
Shale and Lime streaks	300	320	Sandy lime	2775	2800
Sand	320	375	Lime	2800	2845
Dakota Sand	375	400	Lime, shale streaks	2845	2890
Shale	400	435	Sandy lime	2890	2902
Sandy shale	435	465	Lime	2902	2940
Sand	465	540	Lime, sandy	2940	2948
Blue shale	540	560	K. C. lime	2948	3169
Red bed	560	605	Lime	3169	3335
Shale, various shades	605	800	Shale	3335	3380
Shale and salt	800	1112	Lime and shale	3380	3412
Broken lime	1112	1145	Shale, lime streaks	3412	3451
Lime	1145	1180	Shale	3451	3469
Sandy lime, shale streaks	1180	1305	Mississippi lime	3469	3527
Lime	1305	1450	Shale	3527	3545
Lime and shale	1450	1540	Lime	3545	3560
Lime, hard	1540	1550	Shale	3560	3595
Lime, quartz and pyrite	1550	1595	Sand	3595	3600
Lime	1595	1715	Shale	3600	3656
Red rock	1715	1727	Sandy shale	3656	3661
Lime	1727	1780	Chert	3661	3667
Shale	1780	1810	Shale	3667	3679
Lime, shale streaks	1810	1875	Viola lime	3679	3749
Broken lime	1875	1937	Lime	3749	3755
Sandy shale	1937	1970	Shale	3755	3849
Shale and shells	1970	2015	Viola lime	3849	3945
Shale, shells, lime streaks	2015	2065	Lime	3945	4000
Sandy shale	2065	2148	Shale	4000	4058
Lime and shale	2148	2175	Lime	4058	4103
Broken lime	2175	2285			
Conglomerate	2285	2290	TOTAL DEPTH	4103	
Broken lime	2290	2305			
Lime, broken	2305	2362			
Shale	2362	2382	Casing Record:		
Lime	2382	2428	10 3/4" casing set at 309' and cemented		
Shale	2428	2462	with 200 sacks cement		
Topeka lime	2462	2538			
Lime	2538	2565			
Topeka lime	2565	2630			

PLUGGING  
 36 13 7W  
 90 13

