

STATE OF KANSAS
STATE CORPORATION COMMISSION

WELL PLUGGING RECORD

Give All Information Completely
Make Required Affidavit
Mail or Deliver Report to
Conservation Division
State Corporation Comm.
245 North Water
Wichita, KS 67202

Lincoln County, Sec. 14 Twp. 13S Rge. 10W E/W
Location as "NE/CNW $\frac{1}{4}$ SW $\frac{1}{4}$ " or footage from lines
E/2 SE/4 NE/4


Lease Owner Terra Resources, Inc.
Lease Name Homeier Well No. 1
Office Address P. O. Box 839, Oklahoma City, Okla. 73101
Character of Well (Completed as Oil, Gas or Dry Hole) D & A

Date Well completed November 22, 1978
Application for plugging filed November 22, 1978
Application for plugging approved November 22, 1978
Plugging commenced November 22, 1978
Plugging completed November 22, 1978

Reason for abandonment of well or producing formation D & A

If a producing well is abandoned, date of last production 19

Was permission obtained from the Conservation Division or its agents before plugging was commenced? Yes

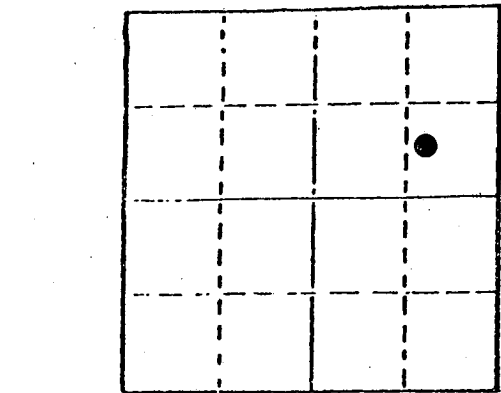

Locate well correctly on above Section Plot

Name of Conservation Agent who supervised plugging of this well Gilbert Toman
Producing formation _____ Depth to top _____ Bottom _____ Total Depth of Well 4,200
Show depth and thickness of all water, oil and gas formations.

OIL, GAS OR WATER RECORDS

CASING RECORD

FORMATION	CONTENT	FROM	TO	SIZE	PUT IN	PULLED OUT
				8 5/8"	453.34'	-0-

Describe in detail the manner in which the well was plugged, indicating where the mud fluid was placed and the method or methods used in introducing it into the hold. If cement or other plugs were used, state the character of same and depth placed, from _____ feet to _____ feet for each plug set.

Hole plugged w/50 sx cement @ 450'
1/2 sx hulls & plug @ 40' w/10 sx cement to surface
2 sx cement in rathole

RECEIVED
STATE CORPORATION COMMISSION

DEC - 7 1978

12-07-1978

CONSERVATION DIVISION
Wichita, Kansas

(If additional description is necessary, use BACK of this sheet)

Name of Plugging Contractor Red Tiger Drilling Company & Allied Cementing

STATE OF Kansas COUNTY OF Sedgwick, ss. contractor
Gloria Fawcett (employee of ~~XXXXXXXXXXXXXXXXXXXXXXXXXXXX~~)


of the above-described well, being first duly sworn on oath, says: That I have knowledge of the facts, statements, and matters herein contained and the log of the above-described well as filed and that the same are true and correct. So help me God.

(Signature) Gloria Fawcett
1720 KSB&T Building, Wichita, Kansas 67202
(Address)

SUBSCRIBED AND SWORN TO before me this 29th day of November, 1978.

Joyce A. Hagermann
Notary Public.

My commission expires _____

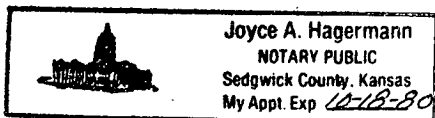

RECEIVED

DEC 1 1978

TERRA RESOURCES, INC.

DRILLERS LOG

15-105-20008-00-00

No. 1 Homeier

CASING RECORD:

COMPANY: Terra Resources, Inc.

DESCRIPTION:

8 5/8" @ 462'
w/285 sx cement

CONTRACTOR: Red Tiger Drilling Company

E/2 SE/4 NE/4
Sec. 14-T13S-R10W
Lincoln County, Kansas

COMMENCED: November 7, 1978

COMPLETED: November 22, 1978

TOTAL DEPTH: 4,200'

ELEVATION: 1,724' KB

FORMATION	FROM	TO	REMARKS
Rock	0	57	
Shale & Sand	57	400	
Sand & Shale	400	438	
Shale	438	470	
Sand	470	530	
Red Bed	530	665	(Anhydrite 626' - 630')
Sand	665	730	
Red Bed, Shale & Sand	730	920	
Shale	920	1275	
Lime & Shale	1275	2610	
Lime	2610	3571	
Lime - Chert	3571	3658	
Lime	3658	4200	
RTD		4200	


I certify that this is a true and correct copy of the above log to the best of my knowledge.

RED TIGER DRILLING COMPANY

Gloria Fawcett
Gloria Fawcett

Subscribed and sworn to before me this 29th day of November, 1978.

Joyce A. Hagermann
Notary Public

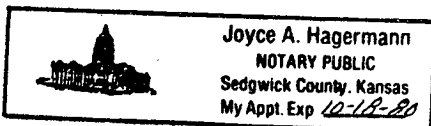

RECEIVED
STATE CORPORATION COMMISSION

DEC - 7 1978
12-07-1978
CONSERVATION LAWS DIV.
Wichita, Kansas

RECEIVED

DEC 1 1978

TERRA RESOURCES, INC.